

**SURVEY & REMONUMENTATION**

APR 05 1996

**COMMISSION**

**OTTAWA COUNTY REMONUMENTATION  
LAND CORNER RECORDATION CERTIFICATE  
Filing Requirement of Act 74, Mich. P.A. 1970**

For corners in

Ottawa (County)	Located in:	Corner Code #
1. Public Land Survey	T <u>7N</u> R <u>16W</u>	G-4, E $\frac{1}{2}$ corner Section 9 Grand Haven Twp
	T _____ R _____	_____
	T _____ R _____	_____
	T _____ R _____	_____
2. Property Controlling in Section	S _____ T _____ R _____	_____
	S _____ T _____ R _____	_____
3. Miscellaneous Property in Sec.	S _____ T _____ R _____	_____
	S _____ T _____ R _____	_____
4. Lot No. _____, Recorded Plat _____		
5. Private Claims _____		

RECORDED

95 NOV 29 PM 1:40

*Elizabeth Robinson*  
REGISTER OF DEEDS  
OTTAWA COUNTY, MI

Register of Deeds Stamp & File Number

I, Thomas E. Joiner, in a field survey on 11/9, 19 95, do hereby certify that under requirements of P.A. 74, Michigan P.A. of 1970, the corner points mentioned in lines 1 and 2 above were in conformance with regulations and rules therefore as required in the current manual of survey instructions of the United States Department of the Interior, Bureau of Land Management or by a decree of a Court of Law and/or that the corner points mentioned in lines 3, 4 and 5 above were in conformance with the rules of the Michigan Board of Land Surveyors or by a Decree of a Court of Law; established, re-established, monumented, re-monumented, recovered, found as expressed below:

	A	B	C	D	E	F	G	H	I	J	K	L	M
2	6	5	4	3	2	1							
3													
4	7	8	9	10	11	12							
5													
6	18	17	16	15	14	13							
7													
8	19	20	21	22	23	24							
9													
10	30	29	28	27	26	25							
11													
12	31	32	33	34	35	36							
13													

**NOTE: Not more than 4 corners, all in the same town and range, may be recorded on this certificate.**

A. Description of original monument and accessories and/or subsequent restoration:

05-22-1832	Liber 4, Page 189	05-27-81
Post Set By Calvin Britain, D.S.	Found 3" Iron	
N 53°E 7 18" Hemlock	Cen. of Hydrant	NE 64.48
S 71°W 28 6" Hemlock	Power Pole	NW 60.07
	Telephone Pole	SE 60.75
	24" Maple	SE 53.73

B. Description of corner evidence found and/or method applied in restoring or reestablishing corner:

Found Cast Iron Monument in Monument Box and accepted as a careful and faithful perpetuation of the position of the original corner.


Liber 4, Page 189		
Cen. of Hydrant	NE	64.48
Power Pole	NW	60.07
Telephone Pole	SE	60.75
24" Maple	SE	53.73

P.A. 345 OTTAWA COUNTY  
PEER APPROVED 11/20/95

*Robert P. McDowell*  
*YDZ*

C. Description of monument for corner and accessories established to perpetuate locating the position of the corner:

Cast Iron Monument		
G <sub>L</sub> Top Operating Bolt on Hydrant	AZ 65°	64.48
O.C. Remon Tag & Nail in SW side Power Pole	AZ 330°	60.60
O.C. Remon Tag & Nail in SW side Telephone Pole	AZ 144°	61.27
O.C. Remon Tag & Nail in SW side 25" Maple	AZ 125°	53.95

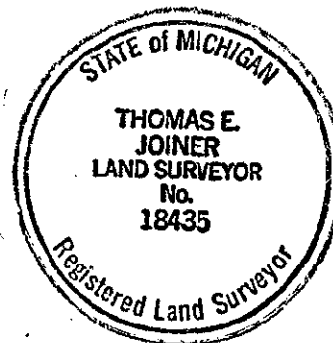

Signed by Thomas E. Joiner  
Surveyor's Michigan License No. 18435

Date 11-16-95