

# SURVEY & REMONUMENTATION

APR 24 1995

COMMISSION

OTTAWA COUNTY REMONUMENTATION  
LAND CORNER RECORDATION CERTIFICATE  
Filing Requirement of Act 74, Mich. P.A. 1970

RECORDED

94 DEC 14 AM 9:40

For corners in

Ottawa <small>(County)</small>	Located In:	Corner Code #
1. Public Land Survey	T <u>7N</u> R <u>16W</u>	G-8, E $\frac{1}{2}$ Cor. Section 21 Grand Haven Twp.
	T _____ R _____	_____
	T _____ R _____	_____
	T _____ R _____	_____
2. Property Controlling in Section	S _____ T _____ R _____	<u>Sec. #1 pm</u>
	S _____ T _____ R _____	_____
3. Miscellaneous Property in Sec.	S _____ T _____ R _____	_____
	S _____ T _____ R _____	_____

*Robert C. Williams*  
REGISTER OF DEEDS  
OTTAWA COUNTY, MI

Register of Deeds Stamp & File Number

4. Lot No. \_\_\_\_\_, Recorded Plat \_\_\_\_\_  
5. Private Claims \_\_\_\_\_

I, THOMAS E. JOINER in a field survey on 11-22-94, 1994, do hereby certify that under requirements of P.A. 74, Michigan P.A. of 1970, the corner points mentioned in lines 1 and 2 above were in conformance with regulations and rules therefore as required in the current manual of survey instructions of the United States Department of the Interior, Bureau of Land Management or by a decree of a Court of Law and/or that the corner points mentioned in lines 3, 4 and 5 above were in conformance with the rules of the Michigan Board of Land Surveyors or by a Decree of a Court of Law; established, re-established, monumented, re-monumented, recovered, found as expressed below:

	A	B	C	D	E	F	G	H	I	J	K	L	M
2	6	5	4	3	2	1							
3													
4	7	8	9	10	11	12							
5													
6	18	17	16	15	14	13							
7													
8	19	20	21	22	23	24							
9													
10	30	29	28	27	26	25							
11													
12	31	32	33	34	35	36							
13													

**NOTE: Not more than 4 corners, all in the same town and range, may be recorded on this certificate.**

A. Description of original monument and accessories and/or subsequent restoration:

05-22-1832	Liber 2, Pg. 719, 01-14-75	Liber 4, Pg. 71, 06-05-80
Post set by J. Mullet, D.S.	Fnd. Angle Iron	Set Cast Iron Monument
N 51°W 16 8" Hemlock	NW 24.16 St. Sign	NW 24.16 Street Sign
S 51°E 7 12" Hemlock	NW 34.25 24" Oak	NW 34.25 24" Oak
	SW 34.27 12" Maple	SW 34.27 12" Maple
Liber 2, Pg. 133, 05-07-73	SE 27.80 22" Oak	SE 27.80 22" Oak
Angle Iron	NE 32.20 17" Maple	NE 32.30 17" Maple
NE 32.95 18" Maple		
SE 28.75 26" Oak		
SW 34.88 12" Maple		
NW 35.57 30" Oak		


B. Description of corner evidence found and/or method applied in restoring or reestablishing corner:

Found Cast Iron Monument and accepted as a careful and faithful perpetuation of the position of the original corner.

Liber 2, Pg. 133, 05-07-73	Liber 4, Pg. 71, 06-05-80
NE 32.95 18" Maple	SE 27.80 22" Oak
SE 28.75 26" Oak	NE 32.30 17" Maple
Liber 2, Pg. 719, 01-14-75	
SE 27.80 22" Oak	
NE 32.20 17" Maple	

PA. 345 OTTAWA COUNTY  
PEER APPROVED 12/12/94

*Madison D. Nedewell*

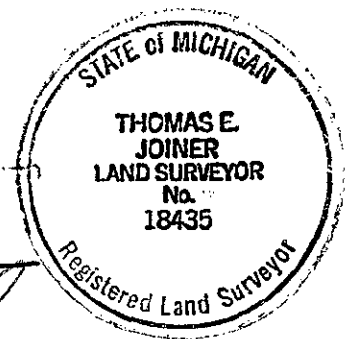

C. Description of monument for corner and accessories established to perpetuate locating the position of the corner:

Cast Iron Monument

O.C. Remon. Tag & Nail in SE side 24" Maple	Az. 55° 32.95
O.C. Remon. Tag & Nail in NE side 30" Oak	Az. 142° 28.84
O.C. Remon. Tag & Nail in NW side 16" Poplar	Az. 222° 47.80
O.C. Remon. Tag & Nail in SW side 30" Oak	Az. 318° 35.10

Signed by Thomas E. Joiner  
Surveyor's Michigan License No. 18435

Date 12-12-94