

SURVEY & REMONUMENTATION

FEB 27 1998 OTTAWA COUNTY REMONUMENTATION

LAND CORNER RECORDATION CERTIFICATE

SECTION Filing Requirement of Act 74, Mich. P.A. 1970

RECORDED

97 OCT 30 AM 10:59

For corners in
Ottawa

(County)

Located In:

Corner Code #

- 1. Public Land Survey T 7N R 16W G-8
T ___ R ___
T ___ R ___ Et corner
T ___ R ___ Sec. 21
- 2. Property Controlling S ___ T ___ R ___ Grand Haven Twp.
in Section S ___ T ___ R ___
- 3. Miscellaneous S ___ T ___ R ___
Property in Sec. S ___ T ___ R ___ Sec #2 pm
- 4. Lot No. _____, Recorded Plat _____
- 5. Private Claims _____

Debra Gant

Register of Deeds
Ottawa County, MI

Register of Deeds Stamp & File Number

I, THOMAS E. JOINER, in a field survey on 7-28- 19 97, do hereby certify that under requirements of P.A. 74, Michigan P.A. of 1970, the corner points mentioned in lines 1 and 2 above were in conformance with regulations and rules therefore as required in the current manual of survey instructions of the United States Department of the Interior, Bureau of Land Management or by a decree of a Court of Law and/or that the corner points mentioned in lines 3, 4 and 5 above were in conformance with the rules of the Michigan Board of Land Surveyors or by a Decree of a Court of Law; established, re-established, monumented, re-monumented, recovered, found as expressed below:

NOTE: Not more than 4 corners, all in the same town and range, may be recorded on this certificate.

	A	B	C	D	E	F	G	H	I	J	K	L	M
2	6	5	4	3	2	1							
3													
4	7	8	9	10	11	12							
5													
6	13	17	16	15	14	13							
7													
8	19	20	21	22	23	24							
9													
10	30	29	28	27	26	25							
11													
12	31	32	33	34	35	36							
13													

A. Description of original monument and accessories and/or subsequent restoration:


- | | | |
|--|---|---|
| G-8 Post set by J. Mullet, D.S.
5-22-1832
8" Hemlock N 51°W 16
12" Hemlock S 51°E 7 | Liber 2, Pg. 133,
5-7-73
Angle Iron
NE 32.95 18" Maple
SE 28.75 26" Oak
SW 34.88 12" Maple
NW 35.57 30" Oak | Liber 2, Pg. 719, 1-14-75
Fnd. Angle Iron
NW 24.16 St. Sign
NW 34.25 24" Oak
SW 34.27 12" Maple
SE 27.80 22" Oak
NE 32.20 17" Maple |
|--|---|---|

(see next page)

B. Description of corner evidence found and/or method applied in restoring or reestablishing corner:

- G-8 Found cast iron monument and accepted as a careful and faithful perpetuation of the position of the original corner.
Set 24" steel bar with O.C. Remon. cap over monument

Liber 2, Page 16
O.C. Remon. Tag & Nail in NW side 16" Poplar AZ 222° 47.80

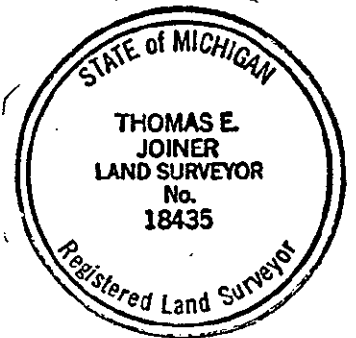

C. Description of monument for corner and accessories established to perpetuate locating the position of the corner:

- G-8 Found cast iron monument set 24" steel bar with O.C. Remon. cap over monument

- | | | |
|--|---------|-------|
| O.C. Remon. Tag & Nail in N. side twin 10" Oak | AZ 77° | 61.37 |
| O.C. Remon. Tag & Nail in N. side power pole | AZ 145° | 52.23 |
| O.C. Remon. Tag & Nail in S. side 7" Red Pine | AZ 276° | 44.30 |
| O.C. Remon. Tag & Nail in NW side 12" Poplar | AZ 222° | 47.74 |
| O.C. Remon. Tag & Nail in N. side 10" Oak | AZ 106° | 73.32 |

\$ 11.00 CORNER
\$ 2.00 PHOTO

On center line North South road and dirt road to East

Signed by Thomas E. Joiner Date 8-18-97
Surveyor's Michigan License No. 18435

Part A. cont.

G-8

Liber 4, Pg. 71, 6-5-80
Set cast iron monument
NW 24.16 St. Sign
NW 34.25 24" Oak
SW 34.27 12" Maple
SE 27.80 22" Oak
NE 32.30 17" Maple

Remon. Liber 2, Page 16 12-12-94
Found cast iron monument

O.C. Remon. Tag & Nail in SE side 24"
Maple AZ 55° 32.95

O.C. Remon. Tag & Nail in NE side 30"
Oak AZ 142° 28.84

O.C. Remon. Tag & Nail in NW side 16"
Poplar AZ 222° 47.80

O.C. Remon. Tag & Nail in SW side 30"
Oak AZ 318° 35.10

**SURVEY &
REMONUMENTATION**

FEB 27 1998

SECTION