

SURVEY & REMONUMENTATION

APR 24 1995

COMMISSION

OTTAWA COUNTY REMONUMENTATION
LAND CORNER RECORDATION CERTIFICATE
 Filing Requirement of Act 74, Mich. P.A. 1970

RECORDED

94 DEC 14 AM 9:40

Elizabeth Carlsson
 REGISTER OF DEEDS
 OTTAWA COUNTY, MI

For corners in

Ottawa (County)	Located In:	Corner Code #
1. Public Land Survey	T <u>7N</u> R <u>16W</u>	<u>G-9, Common</u> <u>Cor. to Sections</u> <u>21, 22, 27 & 28</u>
	T _____ R _____	_____
	T _____ R _____	_____
	T _____ R _____	_____
2. Property Controlling in Section	S _____ T _____ R _____	_____
	S _____ T _____ R _____	_____
3. Miscellaneous Property in Sec.	S _____ T _____ R _____	_____
	S _____ T _____ R _____	_____
4. Lot No. _____	Recorded Plat _____	
5. Private Claims _____		

Register of Deeds Stamp & File Number

I, THOMAS E. JOINER in a field survey on 11-22-94, 19 94, do hereby certify that under requirements of P.A. 74, Michigan P.A. of 1970, the corner points mentioned in lines 1 and 2 above were in conformance with regulations and rules therefore as required in the current manual of survey instructions of the United States Department of the Interior, Bureau of Land Management or by a decree of a Court of Law and/or that the corner points mentioned in lines 3, 4 and 5 above were in conformance with the rules of the Michigan Board of Land Surveyors or by a Decree of a Court of Law; established, re-established, monumented, re-monumented, recovered, found as expressed below:

	A	B	C	D	E	F	G	H	I	J	K	L	M
2	6	5	4	3	2	1							
3													
4	7	8	9	10	11	12							
5													
6	18	17	16	15	14	13							
7													
8	19	20	21	22	23	24							
9													
10	30	29	28	27	26	25							
11													
12	31	32	33	34	35	36							
13													

NOTE: Not more than 4 corners, all in the same town and range, may be recorded on this certificate.

A. Description of original monument and accessories and/or subsequent restoration:

05-22-1832	Liber 1, Pg. 801, 12-08-72	Liber 2, Pg. 133, 05-07-73
Post Set by J. Mullet, D.S.	Fnd. Mon. Box w/1" Pipe	1" Pipe in Mon. Box
N 44°E 24 18" Pine	SE 57.25 10" Cedar	NE 71.25 9" Pine
S 38°W 25 10" Birch	SW 120.25 10" Pine	SE 58.47 T.P.
	NW 67.10 P. Pole	NW 67.75 P.P.
	NE 80.85 11" Pine	

Liber 4, Pg. 311, 04-14-82
 Set Cast Iron Monument
 NW 72.28 Power Pole
 NE 71.20 10" Pine
 SE 58.54 Tele. Pole
 ESE 86.92 24" Aspen


B. Description of corner evidence found and/or method applied in restoring or reestablishing corner:

Found Cast Iron Monument in Monument Box and accepted as a careful and faithful perpetuation of the position of the original corner.

Liber 1, Pg. 801, 12-08-72	Liber 4, Pg. 311, 04-14-82
SE 57.25 10" Cedar	NW 72.28 Power Pole
NE 80.85 11" Pine	NE 71.20 10" Pine
	SE 58.54 Tele. Pole
Liber 2, Pg. 133, 05-07-73	ESE 86.92 24" Aspen
NE 71.25 9" Pine	
SE 58.47 T.P.	

P.A. 345 OTTAWA COUNTY
 PEER APPROVED 12/12/94

Keddy D. Nedewell

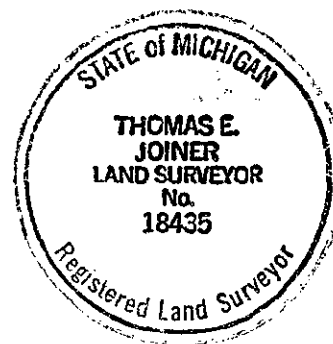

C. Description of monument for corner and accessories established to perpetuate locating the position of the corner:

Cast Iron Monument in Monument Box

O.C. Remon. Tag & Nail in SE side 13" Red Pine	Az. 22°	71.15
O.C. Remon. Tag & Nail in N side 32" Poplar	Az. 123°	87.04
O.C. Remon. Tag & Nail in SE side 14" White Pine	Az. 250°	101.00
O.C. Remon. Tag & Nail in W side 11" Cedar	Az. 160°	57.86

Signed by Thomas E. Joiner
 Surveyor's Michigan License No. 18435

Date 12-12-94