

COMMISSION

OTTAWA COUNTY REMONUMENTATION  
LAND CORNER RECORDATION CERTIFICATE  
Filing Requirement of Act 74, Mich. P.A. 1970

RECORDED

93 DEC 16 PM 1:00

*Phyllis Kullman*  
REGISTER OF DEEDS  
OTTAWA COUNTY, MI

For corners in

<u>Ottawa</u> (County)	Located In:	Corner Code #
1. Public Land Survey	T <u>7N</u> R <u>16W</u>	G-11 N.W. Corner
	T _____ R _____	Section 34
	T _____ R _____	_____
	T _____ R _____	_____
2. Property Controlling in Section	S _____ T _____ R _____	_____
	S _____ T _____ R _____	_____
3. Miscellaneous Property in Sec.	S _____ T _____ R _____	_____
	S _____ T _____ R _____	_____
4. Lot No. _____, Recorded Plat _____		
5. Private Claims _____		

Register of Deeds Stamp & File Number

I, THOMAS E. JOINER in a field survey on 8-27- 19 93, do hereby certify that under requirements of P.A. 74, Michigan P.A. of 1970, the corner points mentioned in lines 1 and 2 above were in conformance with regulations and rules therefore as required in the current manual of survey instructions of the United States Department of the Interior, Bureau of Land Management or by a decree of a Court of Law and/or that the corner points mentioned in lines 3, 4 and 5 above were in conformance with the rules of the Michigan Board of Land Surveyors or by a Decree of a Court of Law; established, re-established, monumented, re-monumented, recovered, found as expressed below:

**NOTE: Not more than 4 corners, all in the same town and range, may be recorded on this certificate.**

A	B	C	D	E	F	G	H	I	J	K	L	M
2	6	5	4	3	2	1						
3												
4	7	8	9	10	11	12						
5												
6	18	17	16	15	14	13						
7												
8	19	20	21	22	23	24						
9												
10	30	29	28	27	26	25						
11												
12	31	32	33	34	35	36						
13												

A. Description of original monument and accessories and/or subsequent restoration:


1" Iron Liber 2, Pg. 753 2-20-75  
 S.W. 36" Oak 49.70  
 S.E. Powerpole 73.35  
 N.W. 20" Walnut 52.29  
 N.W. 22" Maple 66.66

Cast Iron Monument Liber 4, Pg 12 7-18-7  
 N.E. Tel. Marker Post 43.0  
 S.E. 40" Maple 96.77  
 S.W. 35" Oak 48.66  
 S.W. Powerpole 74.83  
 N.W. 21" Walnut 51.55

B. Description of corner evidence found and/or method applied in restoring or reestablishing corner:

Found cast iron monument and accepted as a careful and faithful perpetuation of the position of the original corner.

S.W. 35" Oak 48.66  
 S.W. Powerpole 74.83  
 N.W. 21" Walnut 51.55  
 S.E. 40" Maple 96.77

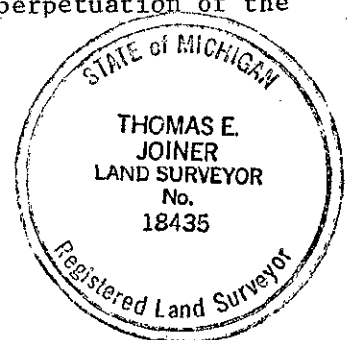

C. Description of monument for corner and accessories established to perpetuate locating the position of the corner:

Cast Iron Monument

O.C. Remon tag & nail South Side 43" Maple S. 70° E. 98.43  
 O.C. Remon tag & nail Southeast Side 12" Oak N. 52° E. 75.30  
 O.C. Remon tag & nail Southwest Side 18" Oak N. 45° W. 87.69  
 O.C. Remon tag & nail Northwest Side 40" Oak S. 38° W. 50.09

Signed by Thomas E. Joiner Date 8-31-93  
 Surveyor's Michigan License No. 18435