

1993

RECORDED

COMMISSION OTTAWA COUNTY REMONUMENTATION LAND CORNER RECORDATION CERTIFICATE

93 DEC 16 PM 1:00

Filing Requirement of Act 74, Mich. P.A. 1970

REGISTER OF DEEDS OTTAWA COUNTY, MI

For corners in

Table with columns: Ottawa (County), Located In, Corner Code #. Includes entries for Public Land Survey, Property Controlling in Section, and Miscellaneous Property in Sec.

Register of Deeds Stamp & File Number

4. Lot No. , Recorded Plat
5. Private Claims

Grid table with columns A-M and rows 1-13. A dot is present in cell C34.

I, THOMAS E. JOINER in a field survey on 8-27-93, do hereby certify that under requirements of P.A. 74, Michigan P.A. of 1970, the corner points mentioned in lines 1 and 2 above were in conformance with regulations and rules therefore as required in the current manual of survey instructions of the United States Department of the Interior, Bureau of Land Management or by a decree of a Court of Law and/or that the corner points mentioned in lines 3, 4 and 5 above were in conformance with the rules of the Michigan Board of Land Surveyors or by a Decree of a Court of Law; established, re-established, monumented, re-monumented, recovered, found as expressed below:

NOTE: Not more than 4 corners, all in the same town and range, may be recorded on this certificate.


A. Description of original monument and accessories and/or subsequent restoration:

Table listing monument descriptions: Steel Fence Post With Sand Stone, Cast Iron Monument, and various trees (Maple, Cherry, Red Pine) with bearings and distances.

B. Description of corner evidence found and/or method applied in restoring or reestablishing corner:

Found cast iron monument and accepted as a careful and faithful perpetuation of the position of the original corner.

Table listing corner evidence: N.W. 38.03 40" Maple, S.E. 35.63 21" Maple, N.E. 70.95 13" Cherry

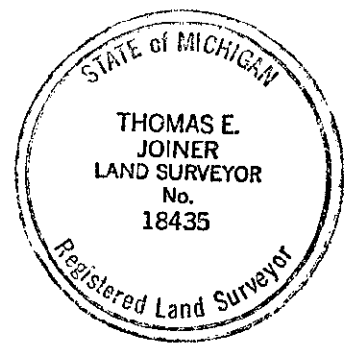

C. Description of monument for corner and accessories established to perpetuate locating the position of the corner:

Table listing monument descriptions: Cast Iron Monument, O.C. Remon tag & nail North Side, O.C. Remon tag & nail N.E. Side, O.C. Remon tag & nail North Side, O.C. Remon tag & nail South Side, with bearings and distances.

Signed by Thomas E. Joiner Date 8-31-93
Surveyor's Michigan License No. 18435