

1993

RECORDED

OTTAWA COUNTY REMONUMENTATION
LAND CORNER RECORDATION CERTIFICATE
Filing Requirement of Act 74, Mich. P.A. 1970

93 DEC 16 PM 1:00

Dorothy Robinson
REGISTER OF DEEDS
OTTAWA COUNTY, MI

For corners in

Ottawa (County)	Located in:	Corner Code #
1. Public Land Survey	T <u>7N</u> R <u>16W</u>	S.W. Corner
	T _____ R _____	Section 34
	T _____ R _____	G-13
	T _____ R _____	
2. Property Controlling in Section	S _____ T _____ R _____	
	S _____ T _____ R _____	
3. Miscellaneous Property in Sec.	S _____ T _____ R _____	
	S _____ T _____ R _____	

Register of Deeds Stamp & File Number

- 4. Lot No. _____, Recorded Plat _____
- 5. Private Claims _____

	A	B	C	D	E	F	G	H	I	J	K	L
2	6	5	4	3	2	1						
3												
4	7	8	9	10	11	12						
5												
6	18	17	16	15	14	13						
7												
8	19	20	21	22	23	24						
9												
10	30	29	28	27	26	25						
11												
12	31	32	33	34	35	36						
13												

I, THOMAS E. JOINER in a field survey on 8-27, 19 93, do hereby certify that under requirements of P.A. 74, Michigan P.A. of 1970, the corner points mentioned in lines 1 and 2 above were in conformance with regulations and rules therefore as required in the current manual of survey instructions of the United States Department of the Interior, Bureau of Land Management or by a decree of a Court of Law and/or that the corner points mentioned in lines 3, 4 and 5 above were in conformance with the rules of the Michigan Board of Land Surveyors or by a Decree of a Court of Law; established, re-established, monumented, re-monumented, recovered, found as expressed below:

NOTE: Not more than 4 corners, all in the same town and range, may be recorded on this certificate.


A. Description of original monument and accessories and/or subsequent restoration:

Angle Iron In Pipe	Cast Iron Monument	Liber 4, Pg. 14	12-21-90
	Port Sheldon Corner	W. 66.0	
	Power Pole	N.E. 48.68	
	9" White Pine	S.E. 44.13	

B. Description of corner evidence found and/or method applied in restoring or reestablishing corner:

Found cast iron monument and accepted as a careful and faithful perpetuation of the position of the original corner.

West 66.00 to Port Sheldon Corner
S.E. 44.57 to Nail West Side 14" Pine
N.W. 114.64 to Nail East Side 10" Pine

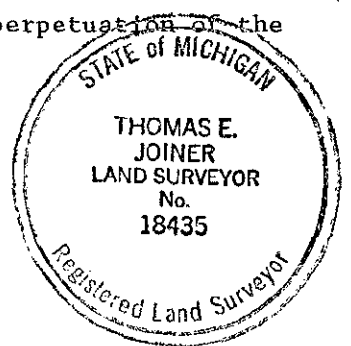

C. Description of monument for corner and accessories established to perpetuate locating the position of the corner:

Cast Iron Monument

O.C. Remon tag & nail South Side	Twin 11" Birch	S. 65° E.	73.55
O.C. Remon tag & nail N.E. Side	12" Red Pine	N. 40° W.	98.63
O.C. Remon tag & nail N.E. Side	10" White Pine	S. 50° E.	56.39
O.C. Remon tag & nail N.W. Side	Power Pole	N. 45° E.	49.21

Signed by Thomas E. Joiner Date 8-31-93
Surveyor's Michigan License No. 18435