

SURVEY &
REMONUMENTATION

APR 05 1996

OTTAWA COUNTY REMONUMENTATION
LAND CORNER RECORDATION CERTIFICATE
Filing Requirement of Act 74, Mich. P.A. 1970

COMMISSION

For corners in

Ottawa (County)	Located In:	Corner Code #
1. Public Land Survey	T 7N R 16W	H-3, S $\frac{1}{4}$ corner Section 3 Grand Haven Twp
	T _____ R _____	_____
	T _____ R _____	_____
	T _____ R _____	_____
2. Property Controlling in Section	S _____ T _____ R _____	_____
	S _____ T _____ R _____	_____
3. Miscellaneous Property in Sec.	S _____ T _____ R _____	_____
	S _____ T _____ R _____	_____
4. Lot No. _____, Recorded Plat _____		
5. Private Claims _____		

RECORDED

95 NOV 29 PM 1:40

Elizabeth Williams
REGISTER OF DEEDS
OTTAWA COUNTY, MI

Register of Deeds Stamp & File Number

I, Thomas E. Joiner, in a field survey on 11/9, 19 95, do hereby certify that under requirements of P.A. 74, Michigan P.A. of 1970, the corner points mentioned in lines 1 and 2 above were in conformance with regulations and rules therefore as required in the current manual of survey instructions of the United States Department of the Interior, Bureau of Land Management or by a decree of a Court of Law and/or that the corner points mentioned in lines 3, 4 and 5 above were in conformance with the rules of the Michigan Board of Land Surveyors or by a Decree of a Court of Law; established, re-established, monumented, re-monumented, recovered, found as expressed below:

NOTE: Not more than 4 corners, all in the same town and range, may be recorded on this certificate.

A. Description of original monument and accessories and/or subsequent restoration:

05-1832	Liber 1, Page 345	04-10-72
Post Set By Calvin Britain, D.S.	Set Cast Iron Monument	
N 11°E 17 12" Hemlock	8" Hemlock	SW 54.01
S 5°E 14 5" Hemlock	10" Maple	N 70.55
	10" Oak	NE 76.00
	12" Beech	SE 75.78
	8" Hemlock	S 47.62

B. Description of corner evidence found and/or method applied in restoring or reestablishing corner:

Found Cast Iron Monument in Monument Box and accepted as a careful and faithful perpetuation of the position of the original corner.

Liber 1, Page 345

8" Hemlock	SW	54.01
10" Maple	N	70.55
12" Beech	SE	75.78
8" Hemlock	S	47.62


P.A. 345 OTTAWA COUNTY
PEER APPROVED 11/20/95

Andrew P. McDowell
YDN

C. Description of monument for corner and accessories established to perpetuate locating the position of the corner:

Cast Iron Monument

O.C. Remon Tag & Nail in N side	12" Hemlock	AZ 240°	54.25
O.C. Remon Tag & Nail in E side	14" White Pine	AZ 7°	45.59
O.C. Remon Tag & Nail in E side	10" Hemlock	AZ 165°	31.70
O.C. Remon Tag & Nail in SW side	8" White Pine	AZ 140°	46.77

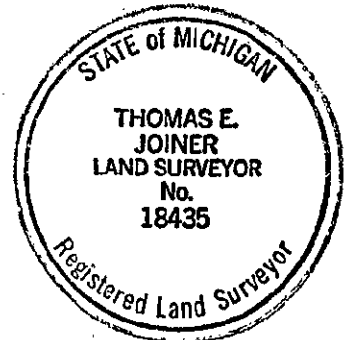

Signed by Thomas E. Joiner
Surveyor's Michigan License No. 18435

Date 11-16-95