

OTTAWA COUNTY REMONUMENTATION
LAND CORNER RECORDATION CERTIFICATE
Filing Requirement of Act 74, Mich. P.A. 1970

RECORDED

93 DEC 16 PM 1:00

D. G. Ballman
REGISTER OF DEEDS
OTTAWA COUNTY, MI

For corners in

Ottawa (County)	Located in:	Corner Code #
1. Public Land Survey	T <u>7N</u> R <u>16W</u>	H-5 N $\frac{1}{2}$ Corner Section 15 Grand Haven Twp
	T _____ R _____	_____
	T _____ R _____	_____
	T _____ R _____	_____
2. Property Controlling in Section	S _____ T _____ R _____	_____
	S _____ T _____ R _____	_____
3. Miscellaneous Property in Sec.	S _____ T _____ R _____	_____
	S _____ T _____ R _____	_____

Register of Deeds Stamp & File Number

- 4. Lot No. _____, Recorded Plat _____
- 5. Private Claims _____

A	B	C	D	E	F	G	H	I	J	K	L	M
2	6	5	4	3	2	1						
3												
4	7	8	9	10	11	12						
5												
6	18	17	16	15	14	13						
7												
8	19	20	21	22	23	24						
9												
10	30	29	28	27	26	25						
11												
12	31	32	33	34	35	36						
13												

I, THOMAS E. JOINER in a field survey on 11-3-, 19 93, do hereby certify that under requirements of P.A. 74, Michigan P.A. of 1970, the corner points mentioned in lines 1 and 2 above were in conformance with regulations and rules therefore as required in the current manual of survey instructions of the United States Department of the Interior, Bureau of Land Management or by a decree of a Court of Law and/or that the corner points mentioned in lines 3, 4 and 5 above were in conformance with the rules of the Michigan Board of Land Surveyors or by a Decree of a Court of Law, established, re-established, monumented, re-monumented, recovered, found as expressed below:

NOTE: Not more than 4 corners, all in the same town and range, may be recorded on this certificate.

A. Description of original monument and accessories and/or subsequent restoration:


Found 3/4" Pipe
Liber 1 Pg. 617 8-31-72

S.E. 3" Ash 42.6
S.W. Gas Line Pole 57.35
N.W. Gas Line Pole 62.0

B. Description of corner evidence found and/or method applied in restoring or reestablishing corner:

Found cast iron monument and accepted as a careful and faithful perpetuation of the position of the original corner.

5" Poplar N.E. 70.87
6" Ash S.E. 51.73
Fence Post S.S.E. 44.41
Gas Line Mkr S.W. 60.00

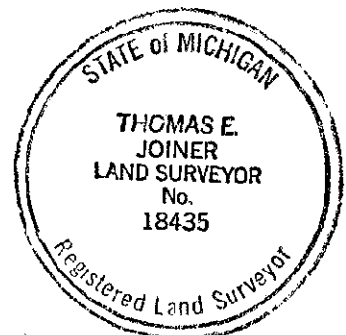

C. Description of monument for corner and accessories established to perpetuate locating the position of the corner:

Cast Iron Monument

O.C. Remon tag & nail in North side 7" Ash S. 32° E. 51.50
O.C. Remon tag & nail in South side 10" Maple S. 61° W. 99.41
O.C. Remon tag & nail in South side 11" White Pine N. 52° W 104.90
O.C. Remon tag & nail in South side 10" Poplar N. 51° E. 69.93

Signed by Thomas E. Joiner Date 11-19-93
Surveyor's Michigan License No. 18435