

**SURVEY & REMONUMENTATION**

APR 24 1995

**COMMISSION**

**OTTAWA COUNTY REMONUMENTATION  
LAND CORNER RECORDATION CERTIFICATE  
Filing Requirement of Act 74, Mich. P.A. 1970**

**RECORDED**

94 DEC 14 AM 9:40

*Phyllis Robinson*  
REGISTER OF DEEDS  
OTTAWA COUNTY, MI

For corners in

Ottawa (County)	Located In:	Corner Code #
1. Public Land Survey	T 7N R 16W	H-9, S½ Cor. Section 22 Grand Haven Twp.
	T _____ R _____	_____
	T _____ R _____	_____
	T _____ R _____	_____
2. Property Controlling in Section	S _____ T _____ R _____	_____
	S _____ T _____ R _____	_____
3. Miscellaneous Property in Sec.	S _____ T _____ R _____	_____
	S _____ T _____ R _____	_____

Register of Deeds Stamp & File Number

4. Lot No. \_\_\_\_\_, Recorded Plat \_\_\_\_\_  
5. Private Claims \_\_\_\_\_

	A	B	C	D	E	F	G	H	I	J	K	L	M
2	6		5		4		3		2		1		
3													
4	7		8		9		10		11		12		
5													
6	18		17		16		15		14		13		
7													
8	19		20		21		22		23		24		
9													
10	30		29		28		27		26		25		
11													
12	31		32		33		34		35		36		
13													

I, THOMAS E. JOINER, in a field survey on 11-22-94, 19 94, do hereby certify that under requirements of P.A. 74, Michigan P.A. of 1970, the corner points mentioned in lines 1 and 2 above were in conformance with regulations and rules therefore as required in the current manual of survey instructions of the United States Department of the Interior, Bureau of Land Management or by a decree of a Court of Law and/or that the corner points mentioned in lines 3, 4 and 5 above were in conformance with the rules of the Michigan Board of Land Surveyors or by a Decree of a Court of Law; established, re-established, monumented, re-monumented, recovered, found as expressed below:

**NOTE: Not more than 4 corners, all in the same town and range, may be recorded on this certificate.**


A. Description of original monument and accessories and/or subsequent restoration:  
05-22-1832 Liber 4, Pg. 212, 07-14-81  
Post Set by John Mullet, D.S. Angle Iron in Mon. Box  
S 40°E 8 8" Maple SE 26.15 P.P.  
N 37°W 38 5" Beech NNW 56.64 14" Pine  
NNE 51.66 8" Pine  
Liber 2, Pg. 133, 05-07-73  
Angle Iron in Mon. Box  
SE 26.15 P.P.  
NNW 56.64 14" Pine  
NNE 51.66 8" Pine

Liber 4, Pg. 311, 04-14-82  
Set Cast Iron Monument  
North 46.08 Power Pole  
SSE 26.21 Power Pole  
NW 61.25 12" Pine  
SW 104.95 12" Ash

B. Description of corner evidence found and/or method applied in restoring or reestablishing corner:  
Found Cast Iron Monument in Monument Box and accepted as a careful and faithful perpetuation of the position of the original corner.

Liber 2, Pg. 133, 05-07-73 Liber 4, Pg. 212, 07-14-81  
SE 26.15 P.P. SE 26.15 P.P.  
NNW 56.64 14" Pine NNW 56.64 14" Pine

Liber 4, Pg. 311, 04-14-82  
North 46.08 Power Pole  
SSE 26.21 Power Pole

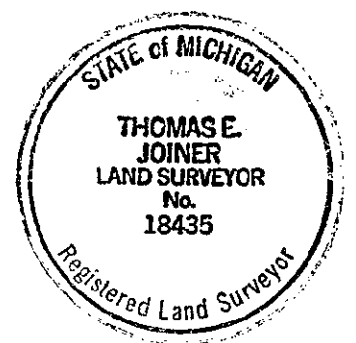

C. Description of monument for corner and accessories established to perpetuate locating the position of the corner:  
Cast Iron Monument in Monument Box

O.C. Remon. Tag & Nail in W side 11" Red Pine	Az. 00°	56.48
O.C. Remon. Tag & Nail in NE side 7" Oak	Az. 150°	46.32
O.C. Remon. Tag & Nail in E side 12" Oak	Az. 200°	59.13
O.C. Remon. Tag & Nail in NE side 13" Red Pine	Az. 340°	56.66

P.A. 345 OTTAWA COUNTY

PEER APPROVED 12/12/94

Signed by Thomas E. Joiner Date 12-12-94  
Surveyor's Michigan License No. 18435