

SURVEY & REMONUMENTATION

APR 05 1996

OTTAWA COUNTY REMONUMENTATION
LAND CORNER RECORDATION CERTIFICATE
 Filing Requirement of Act 74, Mich. P.A. 1970

COMMISSION

For corners in

Ottawa (County)	Located In:	Corner Code #/
1. Public Land Survey	T <u>7N</u> R <u>16W</u>	<u>I-1, NE corner</u>
	T _____ R _____	<u>Section 3</u>
	T _____ R _____	<u>Grand Haven Twp</u>
	T _____ R _____	_____
2. Property Controlling in Section	S _____ T _____ R _____	_____
	S _____ T _____ R _____	_____
3. Miscellaneous Property in Sec.	S _____ T _____ R _____	_____
	S _____ T _____ R _____	_____

RECORDED

95 NOV 29 PM 1:41

Richard R. Robinson
 REGISTER OF DEEDS
 OTTAWA COUNTY, MI

Register of Deeds Stamp & File Number

4. Lot No. _____, Recorded Plat _____
 5. Private Claims _____

	A	B	C	D	E	F	G	H	I	J	K	L	M
2	6	5	4	3	2	1							
3													
4	7	8	9	10	11	12							
5													
6	18	17	16	15	14	13							
7													
8	19	20	21	22	23	24							
9													
10	30	29	28	27	26	25							
11													
12	31	32	33	34	35	36							
13													

I, Thomas E. Joiner, in a field survey on 11-9, 19 95, do hereby certify that under requirements of P.A. 74, Michigan P.A. of 1970, the corner points mentioned in lines 1 and 2 above were in conformance with regulations and rules therefore as required in the current manual of survey instructions of the United States Department of the Interior, Bureau of Land Management or by a decree of a Court of Law and/or that the corner points mentioned in lines 3, 4 and 5 above were in conformance with the rules of the Michigan Board of Land Surveyors or by a Decree of a Court of Law; established, re-established, monumented, re-monumented, recovered, found as expressed below:

NOTE: Not more than 4 corners, all in the same town and range, may be recorded on this certificate.

A. Description of original monument and accessories and/or subsequent restoration:

03-07-1837	Liber 2, Page 421	11-30-73	Liber 4, Page 298	4-1-82
Post Set By Calvin Britain, D.S.	Found 1" Pipe		Found Iron Pipe	
N 32°W 55 10" White Oak	NW Guy Pole 38.57		Power Pole NNW 18.08	
N 70°E 8 24" White Oak	NE P.P. 121.16		9" Ironwood W 23.14	
	SE St. Sign 52.65		8" Ironwood SW 33.24	
			Spring Lake cor. E 21.50	

B. Description of corner evidence found and/or method applied in restoring or reestablishing corner:

Found Cast Iron Monument in Monument Box and accepted as a careful and faithful perpetuation of the position of the original corner.


Liber 2, Page 421	Liber 4, Page 298
SE Street Sign 52.65	Power Pole NNW 18.08
	9" Ironwood W 23.14
	Spring Lake cor. E 21.50

PA. 345 OTTAWA COUNTY
 PEER APPROVED 11/20/95

Richard D. Hedrick
RDH

C. Description of monument for corner and accessories established to perpetuate locating the position of the corner:

Cast Iron Monument		
Spring Lake Corner	AZ 91°	21.50
Top Operating Bolt on Hydrant	AZ 26°	97.51
SW cor. Brick Gar. Hse #14400 160th	AZ 62°	87.62
O.C. Remon Tag & Nail in SW side 11" Maple	AZ 314°	28.92

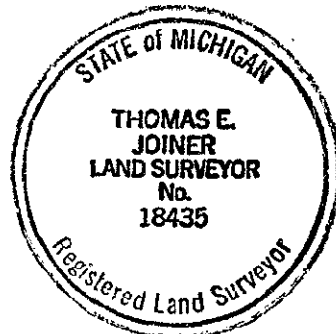

Signed by Thomas E. Joiner Date 11-16-95
 Surveyor's Michigan License No. 18435