

SURVEY &
REMONUMENTATION

APR 05 1996

OTTAWA COUNTY REMONUMENTATION
LAND CORNER RECORDATION CERTIFICATE
Filing Requirement of Act 74, Mich. P.A. 1970

COMMISSION

For corners in

<u>Ottawa</u> <small>(County)</small>	Located In:	Corner Code #	
1. Public Land Survey	T <u>7N</u> R <u>16W</u>	I-2, W $\frac{1}{2}$ Corner	
	T _____ R _____	Section 2	
	T _____ R _____	Grand Haven Twp	
	T _____ R _____		
2. Property Controlling	S _____ T _____ R _____		
in Section	S _____ T _____ R _____		
3. Miscellaneous	S _____ T _____ R _____		
Property in Sec.	S _____ T _____ R _____		

RECORDED

95 NOV 29 PM 1:33

Phyllis Shelton
REGISTER OF DEEDS
OTTAWA COUNTY, MI

Register of Deeds Stamp & File Number

4. Lot No. _____, Recorded Plat _____
5. Private Claims _____

A	B	C	D	E	F	G	H	I	J	K	L	M
2	6	5	4	3	2	1						
3												
4	7	8	9	10	11	12						
5												
6	18	17	16	15	14	13						
7												
8	19	20	21	22	23	24						
9												
10	30	29	28	27	26	25						
11												
12	31	32	33	34	35	36						
13												

I, Thomas E. Joiner, in a field survey on 11/9, 1995, do hereby certify that under requirements of P.A. 74, Michigan P.A. of 1970, the corner points mentioned in lines 1 and 2 above were in conformance with regulations and rules therefore as required in the current manual of survey instructions of the United States Department of the Interior, Bureau of Land Management or by a decree of a Court of Law and/or that the corner points mentioned in lines 3, 4 and 5 above were in conformance with the rules of the Michigan Board of Land Surveyors or by a Decree of a Court of Law; established, re-established, monumented, re-monumented, recovered, found as expressed below:

NOTE: Not more than 4 corners, all in the same town and range, may be recorded on this certificate.

A. Description of original monument and accessories and/or subsequent restoration:

05-20-1832	Liber 3, Page 163	04-27-77	Liber 4, Page 118	11-26-80
Post Set By Calvin Britain, D.S.	Fd. Concrete Monument		Set Cast Iron Monument	
S 29°E 7 8" White Oak	12" Oak	N 30°E 13.8	4" Maple NW 18.86	
N 31°W 23 15" Pine	8" Pine	S 80°E 23.3	14" Oak SW 20.83	
			7" Oak NE 5.38	
			12" Oak SE 25.53	

B. Description of corner evidence found and/or method applied in restoring or reestablishing corner:

Found Cast Iron Monument in Monument Box and accepted as a careful and faithful perpetuation of the position of the original corner.


Liber 3, Page 163	Liber 4, Page 118
12" Oak N 30°E 13.8	4" Maple NW 18.86
8" Pine S 80°E 23.3	15" Oak SW 20.83
	7" Oak NE 5.38
	12" Oak SE 25.53

PA. 345 OTTAWA COUNTY
PEER APPROVED 11/20/95
Robert D. Hedecole
YDY

C. Description of monument for corner and accessories established to perpetuate locating the position of the corner:

Cast Iron Monument

O.C. Remon Tag & Nail in S side	10" Oak	AZ	60°	5.58
O.C. Remon Tag & Nail in N side	8" Maple	AZ	315°	19.21
O.C. Remon Tag & Nail in N side	12" Oak	AZ	145°	26.03
O.C. Remon Tag & Nail in E side	20" Oak	AZ	212°	21.55

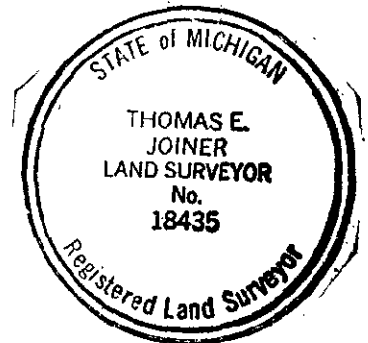

Signed by Thomas E. Joiner Date 11-16-95
Surveyor's Michigan License No. 18435