

**SURVEY &
REMONUMENTATION**

APR 05 1996

**OTTAWA COUNTY REMONUMENTATION
LAND CORNER RECORDATION CERTIFICATE
Filing Requirement of Act 74, Mich. P.A. 1970**

COMMISSION

For corners in

Ottawa (County)	Located In:	Corner Code #
1. Public Land Survey	T <u>7N</u> R <u>16W</u>	I-3, SE corner Section 3 Grand Haven Twp
	T _____ R _____	_____
	T _____ R _____	_____
	T _____ R _____	_____
2. Property Controlling in Section	S _____ T _____ R _____	_____
	S _____ T _____ R _____	_____
3. Miscellaneous Property in Sec.	S _____ T _____ R _____	_____
	S _____ T _____ R _____	_____

RECORDED

95 NOV 29 PM 1:39

Richard A. ...
REGISTER OF DEEDS
OTTAWA COUNTY, MI

Register of Deeds Stamp & File Number

4. Lot No. _____, Recorded Plat _____
5. Private Claims _____

A	B	C	D	E	F	G	H	I	J	K	L	M
2	6	5	4	3	2	1						
3												
4	7	8	9	10	11	12						
5												
6	18	17	16	15	14	13						
7												
8	19	20	21	22	23	24						
9												
10	30	29	28	27	26	25						
11												
12	31	32	33	34	35	36						
13												

I, Thomas E. Joiner, in a field survey on 11/7, 1995, do hereby certify that under requirements of P.A. 74, Michigan P.A. of 1970, the corner points mentioned in lines 1 and 2 above were in conformance with regulations and rules therefore as required in the current manual of survey instructions of the United States Department of the Interior, Bureau of Land Management or by a decree of a Court of Law and/or that the corner points mentioned in lines 3, 4 and 5 above were in conformance with the rules of the Michigan Board of Land Surveyors or by a Decree of a Court of Law; established, re-established, monumented, re-monumented, recovered, found as expressed below:

NOTE: Not more than 4 corners, all in the same town and range, may be recorded on this certificate.

A. Description of original monument and accessories and/or subsequent restoration:

05-20-1832	Liber 1, Page 521	07-13-72
Post Set By Calvin Britain, D.S.	Found 2" Iron Pipe	
N 67° W 48 6" Black Ash	6" Ash SSE	5.15
N 27° E 30 6" Tamarack	5" Ash SE	15.51
	18" Maple East	16.51
	24" Maple N 20° E	36.38
	6" Ash N 35° W	4.36
	15" Ash N 60° W	17.83
	6" Maple S 20° W	22.81

B. Description of corner evidence found and/or method applied in restoring or reestablishing corner:

Found Cast Iron Monument in Monument Box and accepted as a careful and faithful perpetuation of the position of the original corner.

Liber 1, Page 521
6" Ash SSE 5.15
15" Ash N 60°W 17.83


P.A. 345 OTTAWA COUNTY
PEER APPROVED 11/20/95

Richard P. Redwood

C. Description of monument for corner and accessories established to perpetuate locating the position of the corner:

Cast Iron Monument

O.C. Remon Tag & Nail in W side	9" Ash	AZ 165°	5.55
O.C. Remon Tag & Nail in S side	14" Ash	AZ 296°	18.58
O.C. Remon Tag & Nail in SW side	6" Elm	AZ 345°	16.96
O.C. Remon Tag & Nail in SE side	9" Maple	AZ 212°	23.60

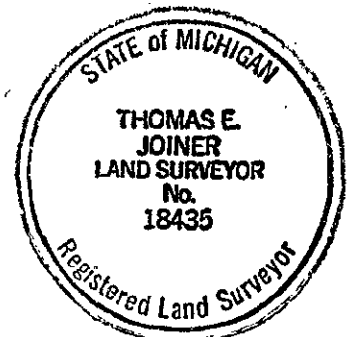

Signed by Thomas E. Joiner Date 11-16-95
Surveyor's Michigan License No. 18435