

OTTAWA COUNTY REMONUMENTATION
LAND CORNER RECORDATION CERTIFICATE
Filing Requirement of Act 74, Mich. P.A. 1970

RECORDED

DEC 16 PM 1:00

Elizabeth Callahan
REGISTER OF DEEDS
OTTAWA COUNTY, MI

For corners in

Ottawa (County)	Located in:	Corner Code #
1. Public Land Survey	T <u>7N</u> R <u>16W</u>	I-5 N.E. corner Section 15 Grand Haven Twp
	T _____ R _____	
	T _____ R _____	
	T _____ R _____	
2. Property Controlling in Section	S _____ T _____ R _____	
	S _____ T _____ R _____	
3. Miscellaneous Property in Sec.	S _____ T _____ R _____	
	S _____ T _____ R _____	

Register of Deeds Stamp & File Number

- 4. Lot No. _____, Recorded Plat _____
- 5. Private Claims _____

	A	B	C	D	E	F	G	H	I	J	K	L	M
2	6	5	4	3	2	1							
3													
4	7	8	9	10	11	12							
5													
6	18	17	16	15	14	13							
7													
8	19	20	21	22	23	24							
9													
10	30	29	28	27	26	25							
11													
12	31	32	33	34	35	36							
13													

I, THOMAS E. JOINER, in a field survey on 11-3-, 19 93, do hereby certify that under requirements of P.A. 74, Michigan P.A. of 1970, the corner points mentioned in lines 1 and 2 above were in conformance with regulations and rules therefore as required in the current manual of survey instructions of the United States Department of the Interior, Bureau of Land Management or by a decree of a Court of Law and/or that the corner points mentioned in lines 3, 4 and 5 above were in conformance with the rules of the Michigan Board of Land Surveyors or by a Decree of a Court of Law; established, re-established, monumented, re-monumented, recovered, found as expressed below.

NOTE: Not more than 4 corners, all in the same town and range, may be recorded on this certificate.

A. Description of original monument and accessories and/or subsequent restoration:

Set Cast Iron Monument
Liber 4, Pg. 314 4-14-82

Found Iron Pipe, set 80 Penny Spike on Top
Liber 1, Pg. 1 5-3-71


Tele. Pole N.W. 56.28
C_L Hydrant N.E. 50.15
C_L St. Sign S.E. 45.25
Power Pole S.S.W. 80.89

Nail in Power Pole S.W. 80.32
10" Maple S. 20° E. 93.96
Tele. Pole N.W. 55.74
10" Tw. Maple S 75° E. 89.52

B. Description of corner evidence found and/or method applied in restoring or reestablishing corner:

Found cast iron monument and accepted as a careful and faithful perpetuation of the position of the original corner.

Tele. Pole N.W. 56.32
C_L Hydrant N.E. 50.15
Power Pole SSW 80.89

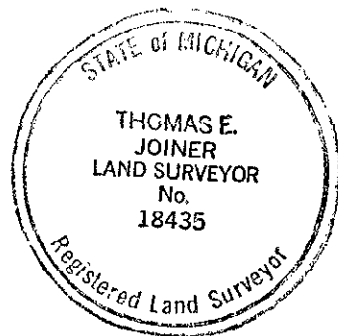

C. Description of monument for corner and accessories established to perpetuate locating the position of the corner:

Cast Iron Monument

O.C. Remon tag & nail East side powerpole	Bearing	S. 17° W.	80.64
O.C. Remon tag & nail East side 56" Maple	Bearing	S. 29° E.	91.20
O.C. Remon tag & nail West side tele. pole	Bearing	N. 33° W.	56.27
C _L Hydrant	Bearing	N. 46° E.	50.24

Signed by Thomas E. Joiner
Surveyor's Michigan License No. 18435

Date 11-19-93