

SURVEY & REMONUMENTATION

APR 24 1995

COMMISSION

OTTAWA COUNTY REMONUMENTATION
LAND CORNER RECORDATION CERTIFICATE
 Filing Requirement of Act 74, Mich. P.A. 1970

RECORDED

94 DEC 14 AM 9:40

Register of Deeds
 REGISTER OF DEEDS
 OTTAWA COUNTY, MI

For corners in

Ottawa (County)	Located In:	Corner Code #
1. Public Land Survey	T 7N R 16W	I-8, E 1/2 Cor. Section 22 Grand Haven Twp.
	T R	
	T R	
	T R	
2. Property Controlling in Section	S T R	
	S T R	
3. Miscellaneous Property in Sec.	S T R	
	S T R	
4. Lot No. _____, Recorded Plat _____		
5. Private Claims _____		

Register of Deeds Stamp & File Number

I, THOMAS E. JOINER, in a field survey on 11-22-94, 1994, do hereby certify that under requirements of P.A. 74, Michigan P.A. of 1970, the corner points mentioned in lines 1 and 2 above were in conformance with regulations and rules therefore as required in the current manual of survey instructions of the United States Department of the Interior, Bureau of Land Management or by a decree of a Court of Law and/or that the corner points mentioned in lines 3, 4 and 5 above were in conformance with the rules of the Michigan Board of Land Surveyors or by a Decree of a Court of Law; established, re-established, monumented, re-monumented, recovered, found as expressed below:

NOTE: Not more than 4 corners, all in the same town and range, may be recorded on this certificate.

	A	B	C	D	E	F	G	H	I	J	K	L	M
2	6	5	4	3	2	1							
3													
4	7	8	9	10	11	12							
5													
6	18	17	16	15	14	13							
7													
8	19	20	21	22	23	24							
9													
10	30	29	28	27	26	25							
11													
12	31	32	33	34	35	36							
13													


A. Description of original monument and accessories and/or subsequent restoration:

05-19-1832	Liber 1, Pg. 569, 08-21-72	Liber 2, Pg. 133, 05-07-73
Post Set by J. Mullet, D.S.	Found Steel Bar beside Steel Fence Post	Found 1/2" Pipe
S 15°W 17 10" Pine	N 35.69 8" Oak	N 35.7 10" Oak
N 40°E 21 15" Pine	NE 37.65 20" Maple	NE 37.6 20" Maple
	SSW 38.60 20" Maple	SE 18.70 26" Maple
	SW 46.75 18" Maple	SW 20.12 15" Maple
	WNW 50.40 8" Maple	

B. Description of corner evidence found and/or method applied in restoring or reestablishing corner:

Found 1/2" Rubberized Iron Pipe and accepted as a careful and faithful perpetuation of the position of the original corner.

Liber 1, Pg. 569, 08-21-72	Liber 2, Pg. 133, 05-07-73
N 35.69 8" Oak	N 35.7 10" Oak
NE 37.65 20" Maple	NE 37.6 20" Maple
SSW 38.60 20" Maple	SE 18.70 26" Maple
SW 46.75 18" Maple	SW 20.12 15" Maple
WNW 50.40 8" Maple	

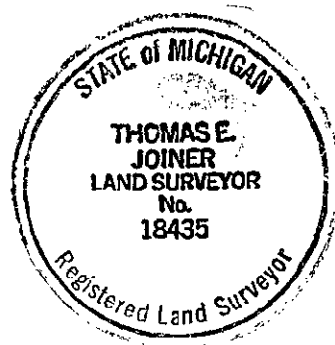

McDoy P. Nedwell RA. 345 OTTAWA COUNTY
 PEER APPROVED 12/12/94

C. Description of monument for corner and accessories established to perpetuate locating the position of the corner:

Replaced 1/2" Rubberized Iron Pipe with Cast Iron Monument.

O.C. Remon. Tag & Nail in W side 10" Oak	Az. 00° 36.18
O.C. Remon. Tag & Nail in S side 24" Maple	Az. 70° 37.90
O.C. Remon. Tag & Nail in W side 26" Maple	Az. 150° 18.70
O.C. Remon. Tag & Nail in SE side 14" Maple	Az. 252° 20.28
Falls on N-S Fence Line and 1' +/- South of Fence to West	

Signed by Thomas E. Joiner Date 12-12-94
 Surveyor's Michigan License No. 18435