

OTTAWA COUNTY REMONUMENTATION
 LAND CORNER RECORDATION CERTIFICATE
 Filing Requirement of Act 74, Mich. P.A. 1970

RECORDED
 94 OCT -7 PM 12: 33

Richard R. Sullivan
 REGISTER OF DEEDS
 OTTAWA COUNTY, MI

or corners in

OTTAWA (County)	Located In:	Corner Code #
Public Land Survey	T <u>7N</u> R <u>16W</u>	I-9, SE Corner Section 22 Grand Haven, Twp.
	T _____ R _____	
	T _____ R _____	
	T _____ R _____	
Property Controlling in Section	S _____ T _____ R _____	
	S _____ T _____ R _____	
Miscellaneous Property In Sec.	S _____ T _____ R _____	
	S _____ T _____ R _____	

Register of Deeds Stamp & File Number

Lot No. _____, Recorded Plat _____
 Private Claims _____

THOMAS E. JOINER in a field survey on MAY 5, 19 94
 do hereby certify that under requirements of P.A. 74, Michigan P.A. of 1970, the corner points mentioned
 in lines 1 and 2 above were in conformance with regulations and rules therefore as required in the
 current manual of survey instructions of the United States Department of the Interior, Bureau of Land
 Management or by a decree of a Court of Law and/or that the corner points mentioned in lines 3, 4 and 5
 above were in conformance with the rules of the Michigan Board of Land Surveyors or by a Decree of a
 Court of Law; established, re-established, monumented, re-monumented, recovered, found as
 expressed below:

NOTE: Not more than 4 corners, all in the same town and range, may be recorded
 on this certificate.

	A	B	C	D	E	F	G	H	I	J	K	L	M
2	6	5	4	3	2	1							
3													
4	7	8	9	10	11	12							
5													
6	18	17	16	15	14	13							
7													
8	19	20	21	22	23	24							
9													
10	30	29	28	27	26	25							
11													
12	31	32	33	34	35	36							
13													


- Description of original monument and accessories and/or subsequent restoration:
 05-19-1832 Liber 4, Pg. 312, 04-14-82 NNW 41.24 18" Pine
 Post set by Calvin Britain, D.S. Set Cast iron monument Liber 2, Pg. 695, 10-22-74
 N65°E 15 6" Hemlock NE 33.70 28" Maple Found monument box
 S57°W 25 6" Hemlock NNW 42.11 22" Pine ESE 78.98 MBT
 NW 54.67 21" Triple Oak NW 52.46 36" Triple Oak
 S 49.47 10" Maple NNW 41.24 18" Pine
 Liber 4, Pg. 212, 08-14-81
 1" Bar in monument box Liber 2, Pg. 151, 05-22-73
 ESE 79.98 MBT Found monument box
 NW 52.46 36" Triple Oak
- Description of corner evidence found and/or method applied in restoring or reestablishing corner:
 Found Cast Iron Monument in Monument Box and accepted as a careful and faithful
 perpetuation of the position of the original corner.
 Liber 4, Pg. 312, 04-14-82 Liber 4, Pg. 212, 08-14-81
 NE 33.70 28" Maple NW 52.46 36" Triple Oak
 NNW 42.11 22" Pine NNW 41.24 18" Pine
 NW 54.67 21" Triple Oak
 S 49.47 10" Maple Liber 2, Pg. 695, 10-22-74
 NW 52.46 36" Triple Oak
 NNW 41.24 18" Pine

P.A. 345 OTTAWA COUNTY

PEER APPROVED *9/2/94*

George P. Medved

- Description of monument for corner and accessories established to perpetuate locating the position of the corner:
 Cast Iron Monument in Monument Box
 E Operating Nut Top Fire Hydrant
 O.C. Remon. Tag & Nail in NE side 50" Triple Oak Az. 10° 32.37
 O.C. Remon. Tag & Nail in SE side 30" Maple Az. 307° 52.78
 O.C. Remon. Tag & Nail in East side 12" Maple Az. 45° 33.69
 O.C. Remon. Tag & Nail in East side 12" Maple Az. 175° 49.40

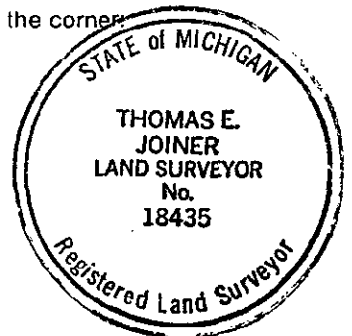

Signed by *Thomas E. Joiner* Date 9-2-94
 Surveyor's Michigan License No. 18435