

OTTAWA COUNTY REMONUMENTATION
LAND CORNER RECORDATION CERTIFICATE
 Filing Requirement of Act 74, Mich. P.A. 1970

RECORDED

94 OCT -7 PM 12:33

For corners in

Dorothy C. Cullman
 REGISTER OF DEEDS
 OTTAWA COUNTY, MI

| | | |
|---------------------------------------|-------------|------------------------------|
| OTTAWA (County) | Located In: | Corner Code # |
| 1. Public Land Survey | T 7N R 16W | I-10, W $\frac{1}{2}$ Corner |
| | T R | Section 26 |
| | T R | Grand Haven Twp. |
| | T R | |
| 2. Property Controlling in Section | S T R | |
| | S T R | |
| 3. Miscellaneous Property in Sec. | S T R | |
| | S T R | |
| 4. Lot No. _____, Recorded Plat _____ | | |
| 5. Private Claims _____ | | |

Register of Deeds Stamp & File Number

I, THOMAS E. JOINER in a field survey on MAY 5, 19 99, do hereby certify that under requirements of P.A. 74, Michigan P.A. of 1970, the corner points mentioned in lines 1 and 2 above were in conformance with regulations and rules therefore as required in the current manual of survey instructions of the United States Department of the Interior, Bureau of Land Management or by a decree of a Court of Law and/or that the corner points mentioned in lines 3, 4 and 5 above were in conformance with the rules of the Michigan Board of Land Surveyors or by a Decree of a Court of Law; established, re-established, monumented, re-monumented, recovered, found as expressed below:

| | | | | | | | | | | | | | |
|----|----|----|----|----|----|----|---|---|---|---|---|---|---|
| | A | B | C | D | E | F | G | H | I | J | K | L | M |
| 2 | 6 | 5 | 4 | 3 | 2 | | | | | | | | |
| 3 | | | | | | | | | | | | | |
| 4 | 7 | 8 | 9 | 10 | 11 | 12 | | | | | | | |
| 5 | | | | | | | | | | | | | |
| 6 | 13 | 17 | 16 | 15 | 14 | 13 | | | | | | | |
| 7 | | | | | | | | | | | | | |
| 8 | 19 | 20 | 21 | 22 | 23 | 24 | | | | | | | |
| 9 | | | | | | | | | | | | | |
| 10 | 30 | 29 | 28 | 27 | 26 | 25 | | | | | | | |
| 11 | | | | | | | | | | | | | |
| 12 | 31 | 32 | 33 | 34 | 35 | 36 | | | | | | | |
| 13 | | | | | | | | | | | | | |


NOTE: Not more than 4 corners, all in the same town and range, may be recorded on this certificate.

- A. Description of original monument and accessories and/or subsequent restoration:
 05-19-1832 Liber 5, Pg. 108, 06-14-84 SSE 128.40
 Post Set by Calvin Britain, D.S. Cast iron monument NW Cor. Porch
 S41°E 20 8" Hemlock NNE 55.43 Power Pole House # 16018
 N54°W 23 6" White Ash SSE 128.45 NW Cor. Porch Hse. #16018
 South 26.43 8" Pine
 South 81.60 Power Pole
 Liber 2, Pg. 695, 11-22-74
 Found monument box
 N 55.39 Power Pole
 SSW 46.60 Telephone Pole
- B. Description of corner evidence found and/or method applied in restoring or reestablishing corner:
 Found Cast Iron Monument in Monument Box and accepted as a careful and faithful perpetuation of the position of the original corner.
- Liber 5, Pg. 108, 06-14-84 NNE 55.43 Power Pole
 SSE 128.45 NW Cor. Porch House # 16018
- Liber 2, Pg. 695, 11-22-74 North 55.39 Power Pole
 SSE 128.40 NW Cor. Porch House #16018

PA. 345 OTTAWA COUNTY
 PEER APPROVED 9/2/94

Walter D. Nedeweled

- C. Description of monument for corner and accessories established to perpetuate locating the position of the corner:
 Cast Iron Monument in Monument Box
 O.C. Remon. Tag & Nail in NW side of power pole Az. 13° 55.88
 Cut notch in 2nd Rib in S end 30" CMP Az. 344° 28.43
 O.C. Remon. Tag & Nail in NE side 10" Cedar Az. 145° 36.34
 O.C. Remon. Tag & Nail in West side Twin 8" White Pine Az. 172° 53.41

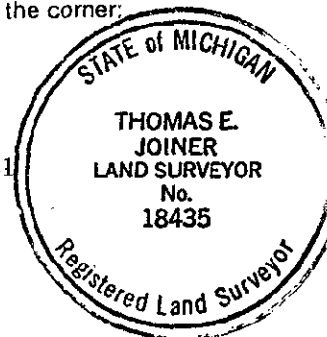

Signed by Thomas E. Joiner Date 9-2-94
 Surveyor's Michigan License No. 18435