RECEIVED
1993
COMMISSION

OTTAWA COUNTY REMONUMENTATION
LAND CORNER RECORDATION CERTIFICATE
Filing Requirement of Act 74, Mich. P.A. 1970

RECORDED
93 DEC 16 PM 1:00
REGISTER OF DEEDS
OTTAWA COUNTY, MI

For corners in

Ottawa (County)

	Located In:	Corner Code ##
1. Public Land Survey	T 7N R 16W	I-11 N.E. Corner
	T ___ R ___	Section 34
	T ___ R ___	
	T ___ R ___	
2. Property Controlling	S ___ T ___ R ___	
in Section	S ___ T ___ R ___	
3. Miscellaneous	S ___ T ___ R ___	
Property in Sec.	S ___ T ___ R ___	

Register of Deeds Stamp & File Number

4. Lot No. _____, Recorded Plat _____
5. Private Claims _____

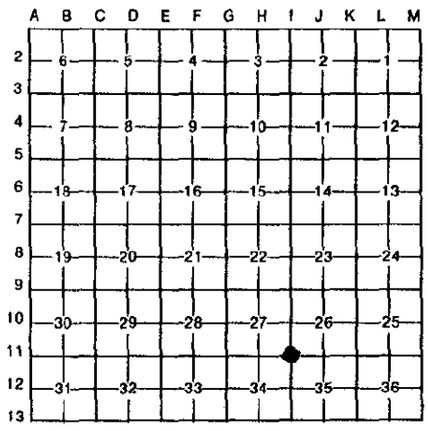

I, THOMAS E. JOINER, in a field survey on 10-28-, 19 93, do hereby certify that under requirements of P.A. 74, Michigan P.A. of 1970, the corner points mentioned in lines 1 and 2 above were in conformance with regulations and rules therefore as required in the current manual of survey instructions of the United States Department of the Interior, Bureau of Land Management or by a decree of a Court of Law and/or that the corner points mentioned in lines 3, 4 and 5 above were in conformance with the rules of the Michigan Board of Land Surveyors or by a Decree of a Court of Law; established, re-established, monumented, re-monumented, recovered, found as expressed below:

NOTE: Not more than 4 corners, all in the same town and range, may be recorded on this certificate.

A. Description of original monument and accessories and/or subsequent restoration:

1" Pipe

Cast Iron Monument Liber 4, Pg. 12 12-11-79

S.W. 44.62 Tel. Cable Box
S.W. 32.70 S.W. End 30" Corr. Culv.
N.E. 25.22 St. Sign
N.E. 41.38 9" Red Pine

B. Description of corner evidence found and/or method applied in restoring or reestablishing corner:

Found cast iron monument and accepted as a careful and faithful perpetuation of the position of the original corner.

S.W. 44.62 Tel. Marker
S.W. 32.70 S.W. End 30" Corr. Culv.
N.E. 41.38 9" Red Pine

STATE of MICHIGAN
THOMAS E. JOINER
LAND SURVEYOR
No. 18435
Registered Land Surveyor

C. Description of monument for corner and accessories established to perpetuate locating the position of the corner:

Cast Iron Monument

O.C. Remon tag & nail 12" Cherry S. 20° E. 77.21
O.C. Remon tag & nail 10" White Oak N. 35° W. 54.24
O.C. Remon tag & nail 12" Red Pine N. 25° E. 47.43
O.C. Remon tag & nail Tel. Pole S. 65° E. 86.72

Signed by Thomas E. Joiner Date 11-4-93
Surveyor's Michigan License No. 18435

FORM APPROVED BY MICHIGAN STATE BOARD OF LAND SURVEYORS, JAN. 28, 1971
REVISED MAY 14, 1975
REVISED JAN., 1983