For corners in

RECORDED

OTTAWA COUNTY REMONUMENTATION LAND CORNER RECORDATION CERTIFICATE

Requirement of Act 74, Mich. P.A. 1970



Deligica Calman

	Ottawa (County)		Located In:	Corner Code ##	REGISTER OF DEEDS OTTAWA COUNTY, MI
1.	Public Land Survey		T 7N R 16W T R T R T R		
2.	Property Controlling	s	R	9	
	in Section	S	T R		
3.	Miscellaneous	S	T R		Register of Deeds Stamp & File Number
	Property in Sec.	s	T B		
					A B C D E F G H I J K L
5.	Private Claims				
1.	THOMAS E. JOINE	Σίn a fie	eld survey on	10-28- 19 93	
do	hereby certify that under re	quiremen	ts of P.A. 74, Michigan P.	A. of 1970, the corner points mention	ned s

expressed below: NOTE: Not more than 4 corners, all in the same town and range, may be recorded on this certificate.

in lines 1 and 2 above were in conformance with regulations and rules therefore as required in the

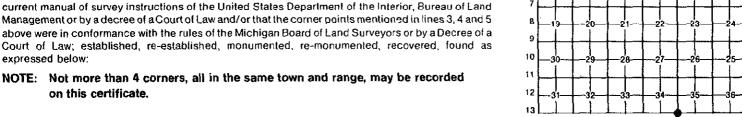

A. Description of original monument and accessories and/or subsequent restoration:

Cast Iron Monument	Cast Iron	Monumen	t Liber 1, Pg. 119	10-19-71
At Government survey distance from Port Sheldon Twp corner	S. 80° E. N.E. N.E. North South	80.62 70.95 37.87	Nail in 30" Oak Nail in Power Pole Nail in 16" Ash Nail in 12" Cherry Nail in 18" Ash	

B. Description of corner evidence found and/or method applied in restoring or reestablishing corner:

Found cast iron monument and accepted as a careful and faithful perpetuation of the position of the original corner.

80.62 Power Pole N.E. 37.87 12" Cherry N. 70.95 16" Ash N.E.



C. Description of monument for corner and accessories established to perpetuate locating the position of the corner

Cast Iron Monument

O.C.	Remon	tag	& nail	511	Oak	s.	0°	W.	61.42
					Twin As	sh N.	50°	W.	45.09
0.C.	Remon	tag	& nail	Powe	er Pole	N.	45°	E.	81.09
	C_{τ}	Тор	of Hyd	irant	t	N.	60°	E.	65.42

Signed by Thomas C. James	Date
1000	
Surveyor's Michigan License No	FORM APPROVED BY MICHIGAN STATE BOARD OF LAND SURVEYORS, JAN. 28, 1971