

# SURVEY & REMONUMENTATION

APR 24 1995

OTTAWA COUNTY REMONUMENTATION  
LAND CORNER RECORDATION CERTIFICATE  
Filing Requirement of Act 74, Mich. P.A. 1970

RECORDED

94 DEC 14 AM 9:40

For corners in **COMMISSION**

Ottawa <small>(County)</small>	Located In:	Corner Code <del>==</del>	
1. Public Land Survey	T <u>7N</u> R <u>16W</u>	J-3, S $\frac{1}{2}$ Cor.	
	T _____ R _____	Section 2	
	T _____ R _____	Grand Haven Twp.	
	T _____ R _____		
2. Property Controlling in Section	S _____ T _____ R _____		
	S _____ T _____ R _____		
3. Miscellaneous Property in Sec.	S _____ T _____ R _____		
	S _____ T _____ R _____		
4. Lot No. _____, Recorded Plat _____			
5. Private Claims _____			

*Richard R. Robinson*  
REGISTER OF DEEDS  
OTTAWA COUNTY, MI

Register of Deeds Stamp & File Number

I, THOMAS E. JOINER, in a field survey on 11-22- 19 94, do hereby certify that under requirements of P.A. 74, Michigan P.A. of 1970, the corner points mentioned in lines 1 and 2 above were in conformance with regulations and rules therefore as required in the current manual of survey instructions of the United States Department of the Interior, Bureau of Land Management or by a decree of a Court of Law and/or that the corner points mentioned in lines 3, 4 and 5 above were in conformance with the rules of the Michigan Board of Land Surveyors or by a Decree of a Court of Law; established, re-established, monumented, re-monumented, recovered, found as expressed below:

**NOTE: Not more than 4 corners, all in the same town and range, may be recorded on this certificate.**

	A	B	C	D	E	F	G	H	I	J	K	L	M
2	6	5	4	3	2	1							
3										●			
4	7	8	9	10	11	12							
5													
6	18	17	16	15	14	13							
7													
8	19	20	21	22	23	24							
9													
10	30	29	28	27	26	25							
11													
12	31	32	33	34	35	36							
13													


A. Description of original monument and accessories and/or subsequent restoration:  
 05-22-1832 Liber 1, Pg. 521, 07-13-72  
 Post Set by J. Mullet, D.S. Set Cast Iron Monument  
 N 59°W 25 10" White Oak E 47.47 12" Beech  
 South 20 6" Beech N 35.70 16" Oak  
 W 31.38 18" Pine  
 N 8.91 24" Pine

B. Description of corner evidence found and/or method applied in restoring or reestablishing corner:  
 Found Cast Iron Monument and accepted as a careful and faithful perpetuation of the position of the original corner.

Liber 1, Pg. 521, 07-13-72  
 N 35.70 16" Oak  
 N 8.91 24" Pine

P.A. 345 OTTAWA COUNTY  
 PEER APPROVED 12/12/94

*Kendy D. Newbold*

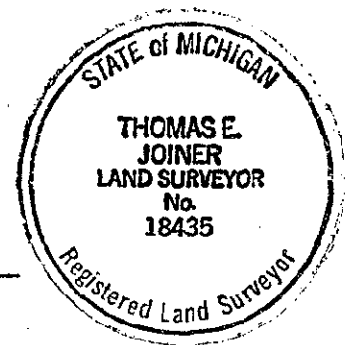

C. Description of monument for corner and accessories established to perpetuate locating the position of the corner:

Cast Iron Monument

O.C. Remon. Tag & Nail in W side 21" Hemlock	Az. 40° 9.50
O.C. Remon. Tag & Nail in NW side 22" Oak	Az. 70° 12.75
O.C. Remon. Tag & Nail in W side 10" Poplar	Az. 180° 49.63
O.C. Remon. Tag & Nail in S side 21" Oak	Az. 285° 32.27
5' Ditch 5' South	

Signed by Thomas E. Joiner Date 12-12-94  
 Surveyor's Michigan License No. 18435