

SURVEY & REMONUMENTATION

APR 24 1995

COMMISSION

OTTAWA COUNTY REMONUMENTATION LAND CORNER RECORDATION CERTIFICATE Filing Requirement of Act 74, Mich. P.A. 1970

RECORDED

94 DEC 14 AM 9:40

D. J. Coleman
REGISTER OF DEEDS
OTTAWA COUNTY, MI

For corners in

Ottawa <small>(County)</small>	Located In:	Corner Code #	
1. Public Land Survey	T <u>7N</u> R <u>16W</u>	J-5, S $\frac{1}{2}$ Cor.	
	T _____ R _____	Section 11	
	T _____ R _____	Grand Haven Twp.	
	T _____ R _____		
2. Property Controlling in Section	S _____ T _____ R _____		
	S _____ T _____ R _____		
3. Miscellaneous Property in Sec.	S _____ T _____ R _____		
	S _____ T _____ R _____		
4. Lot No. _____, Recorded Plat _____			
5. Private Claims _____			

Register of Deeds Stamp & File Number

I, THOMAS E. JOINER, in a field survey on 11-22-94, 19 94, do hereby certify that under requirements of P.A. 74, Michigan P.A. of 1970, the corner points mentioned in lines 1 and 2 above were in conformance with regulations and rules therefore as required in the current manual of survey instructions of the United States Department of the Interior, Bureau of Land Management or by a decree of a Court of Law and/or that the corner points mentioned in lines 3, 4 and 5 above were in conformance with the rules of the Michigan Board of Land Surveyors or by a Decree of a Court of Law; established, re-established, monumented, re-monumented, recovered, found as expressed below:

NOTE: Not more than 4 corners, all in the same town and range, may be recorded on this certificate.

	A	B	C	D	E	F	G	H	I	J	K	L	M
2	6	5	4	3	2	1							
3													
4	7	8	9	10	11	12							
5													
6	18	17	16	15	14	13							
7													
8	19	20	21	22	23	24							
9													
10	30	29	28	27	26	25							
11													
12	31	32	33	34	35	36							
13													


A. Description of original monument and accessories and/or subsequent restoration:

05-22-1832	Liber 1, Pg. 3, 05-03-71	Liber 4, Pg. 313, 04-14-82
Post set by J. Mullet, D.S.	Found 1" Iron Pipe	Set Cast Iron Monument
N 26°W 23 12" Hemlock	SE 41.56 22" Maple	NNE 37.48 Cen. of Hydrant
S 33°W 14 14" Hemlock	NE 93.37 6" Pine	NE 74.92 13" Pine
	NE 45.09 10" Maple	N 65.96 4" Dogwood
	SW 21.0 $\frac{1}{2}$ S. End Metal Culvert	SW 31.73 Corr. Culv.

B. Description of corner evidence found and/or method applied in restoring or reestablishing corner:

Found Cast Iron Monument in Monument Box and accepted as a careful and faithful perpetuation of the position of the original corner.

Liber 4, Pg. 313, 04-14-82
 NNE 37.48 Cen. of Hydrant
 NE 74.92 13" Pine
 N "65.96" 4" Dogwood (typing error dist. meas. = 55.95)
 SW 31.73 Corr. Culv.

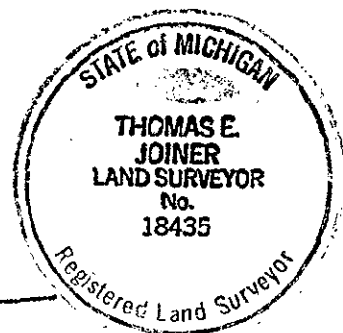

Madison D. McDowell
 P.A. 345 OTTAWA COUNTY
 PEER APPROVED 12/12/94

C. Description of monument for corner and accessories established to perpetuate locating the position of the corner:

Cast Iron Monument in Monument Box

$\frac{1}{2}$ Top Operating Nut on Hydrant	Az. 20° 37.48
O.C. Remon. Tag & Nail in SE side 13" White Pine	Az. 41° 75.00
O.C. Remon. Tag & Nail in E side 5" Dogwood	Az. 00° 55.95
PK Nail in Top of SE End 48" CMP	Az. 222° 31.56

Signed by Thomas E. Joiner Date 12-12-94
 Surveyor's Michigan License No. 18435