

REMONUMENTATION

APR 24 1995

COMMISSION

OTTAWA COUNTY REMONUMENTATION  
LAND CORNER RECORDATION CERTIFICATE  
Filing Requirement of Act 74, Mich. P.A. 1970

RECORDED

94 DEC 14 AM 9:40

*Register of Deeds*  
REGISTER OF DEEDS  
OTTAWA COUNTY, MI

For corners in

Ottawa (County)	Located In:	Corner Code ##
1. Public Land Survey	T 7N R 16W	J-7, S 1/2 Cor. Section 14 Grand Haven Twp.
	T _____ R _____	_____
	T _____ R _____	_____
	T _____ R _____	_____
2. Property Controlling in Section	S _____ T _____ R _____	_____
	S _____ T _____ R _____	_____
3. Miscellaneous Property in Sec.	S _____ T _____ R _____	_____
	S _____ T _____ R _____	_____
4. Lot No. _____, Recorded Plat _____		
5. Private Claims _____		

Register of Deeds Stamp & File Number

I, THOMAS E. JOINER, in a field survey on 11-22-94, 19 94, do hereby certify that under requirements of P.A. 74, Michigan P.A. of 1970, the corner points mentioned in lines 1 and 2 above were in conformance with regulations and rules therefore as required in the current manual of survey instructions of the United States Department of the Interior, Bureau of Land Management or by a decree of a Court of Law and/or that the corner points mentioned in lines 3, 4 and 5 above were in conformance with the rules of the Michigan Board of Land Surveyors or by a Decree of a Court of Law; established, re-established, monumented, re-monumented, recovered, found as expressed below:

NOTE: Not more than 4 corners, all in the same town and range, may be recorded on this certificate.

	A	B	C	D	E	F	G	H	I	J	K	L	M
2	6	5	4	3	2								
3													
4	7	8	9	10	11	12							
5													
6	18	17	16	15	14	13							
7													
8	19	20	21	22	23	24							
9													
10	30	29	28	27	26	25							
11													
12	31	32	33	34	35	36							
13													

A. Description of original monument and accessories and/or subsequent restoration:

05-19-1832	Liber 1, Pg. 571, 08-02-72	Liber 4, Pg. 70, 06-05-80
Post Set by J. Mullet, D.S.	Found Steel Bar	Set Cast Iron Monument
N 43°E 36 Hemlock	SE 66.32 20" Pine	NW 53.28 10" Triple Beech
S 65°E 61 14" Beech	NE 32.42 Power Pole	SSE 21.76 Telephone Ped.
	SW 61.37 Ⓞ Street Sign	SE 72.04 9" Pine
	NW 53.24 Triple 10" Beech	SW 61.20 Ⓞ Street Sign

B. Description of corner evidence found and/or method applied in restoring or reestablishing corner:


Found Cast Iron Monument and accepted as a careful and faithful perpetuation of the position of the original corner.

Liber 1, Pg. 571, 08-02-72	Liber 4, Pg. 70, 06-05-80
NW 53.24 Triple 10" Beech (Oak)	NW 53.28 10" Triple Beech (Oak)
	SSE 21.76 Telephone Ped.

P.A. 345 OTTAWA COUNTY

PEER APPROVED 12/12/94

*Madison P. Nedweld*

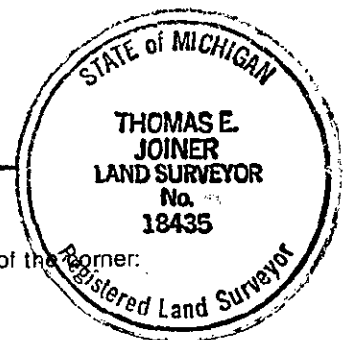

C. Description of monument for corner and accessories established to perpetuate locating the position of the corner:

Cast Iron Monument

O.C. Remon. Tag & Nail in W side 16" Red Pine	Az. 162° 85.77
O.C. Remon. Tag & Nail in E side 10" Red Pine	Az. 192° 54.00
O.C. Remon. Tag & Nail in W side 20" Sassafras	Az. 350° 26.75
O.C. Remon. Tag & Nail in E side Triple 16" Oak	Az. 332° 53.67

Signed by Thomas E. Joiner Date 12-12-94  
Surveyor's Michigan License No. 18435