

# SURVEY & REMONUMENTATION

APR 24 1995

COMMISSION

OTTAWA COUNTY REMONUMENTATION  
LAND CORNER RECORDATION CERTIFICATE  
Filing Requirement of Act 74, Mich. P.A. 1970

RECORDED

94 DEC 14 AM 9:40

*Phyllis Anderson*  
REGISTER OF DEEDS  
OTTAWA COUNTY, MI

For corners in

OTTAWA <small>(County)</small>	Located In:	Corner Code #/
1. Public Land Survey	T <u>7N</u> R <u>16W</u>	K-3, SW Corner Section 1 Grand Haven Twp.
	T _____ R _____	_____
	T _____ R _____	_____
	T _____ R _____	_____
2. Property Controlling in Section	S _____ T _____ R _____	_____
	S _____ T _____ R _____	_____
3. Miscellaneous Property in Sec.	S _____ T _____ R _____	_____
	S _____ T _____ R _____	_____
4. Lot No. _____, Recorded Plat _____		
5. Private Claims _____		

Register of Deeds Stamp & File Number

I, THOMAS E. JOINER in a field survey on 10-28- 19 94, do hereby certify that under requirements of P.A. 74, Michigan P.A. of 1970, the corner points mentioned in lines 1 and 2 above were in conformance with regulations and rules therefore as required in the current manual of survey instructions of the United States Department of the Interior, Bureau of Land Management or by a decree of a Court of Law and/or that the corner points mentioned in lines 3, 4 and 5 above were in conformance with the rules of the Michigan Board of Land Surveyors or by a Decree of a Court of Law; established, re-established, monumented, re-monumented, recovered, found as expressed below:

**NOTE: Not more than 4 corners, all in the same town and range, may be recorded on this certificate.**

	A	B	C	D	E	F	G	H	I	J	K	L	M
2	6	5	4	3	2	1							
3													
4	7	8	9	10	11	12							
5													
6	18	17	16	15	14	13							
7													
8	19	20	21	22	23	24							
9													
10	30	29	28	27	26	25							
11													
12	31	32	33	34	35	36							
13													

A. Description of original monument and accessories and/or subsequent restoration:

05-18-1832	Liber 1, Pg. 521, 07-13-72
Post set by Calvin Britain, D.S.	Set Cast Iron Monument
S55°E 12 18" Hemlock	SW 55.83 Nail in face of 10" Oak
N54°W 23 4" Hemlock	WSW 29.32 Nail in face of 24" Oak
	NW 51.94 Nail in face of 6" Red Pine
	SE 37.19 Nail in face of 20" White Pine
	NE 81.84 Nail in face of Telephone Pole


B. Description of corner evidence found and/or method applied in restoring or reestablishing corner:

Found Cast Iron Monument in Monument Box and accepted as a careful and faithful perpetuation of the position of the original corner.

Liber 1, Pg. 521, 07-13-72  
SE 37.19 Nail in face of 20" White Pine  
NW 51.94 Nail in face of 6" Red Pine

P.A. 345 OTTAWA COUNTY  
PEER APPROVED 12/12/94

*Madison P. Newbold*

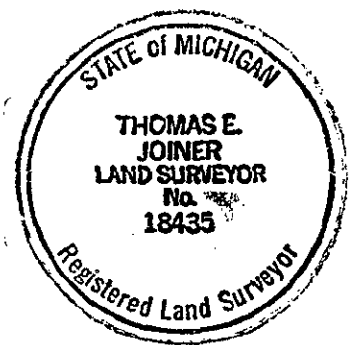

C. Description of monument for corner and accessories established to perpetuate locating the position of the corner:

Cast Iron Monument

SW corner concrete foundation house #13606	Az. 88°	96.05
O.C. Remon. Tag & Nail in SW side 26" White Pine	Az. 132°	37.39
O.C. Remon. Tag & Nail in N side 10" Red Oak	Az. 275°	61.60
O.C. Remon. Tag & Nail in N side 12" Red Pine	Az. 306°	52.32

Signed by Thomas E. Joiner Date 11-28-94  
Surveyor's Michigan License No. 18435