

**OTTAWA COUNTY REMONUMENTATION
LAND CORNER RECORDATION CERTIFICATE
Filing Requirement of Act 74, Mich. P.A. 1970**

For corners in
Ottawa
(County)

Located In:

Corner Code #

- | | | |
|---------------------------------------|------------------------|-----------------------------|
| 1. Public Land Survey | T <u>7</u> R <u>16</u> | K-4, E $\frac{1}{2}$ corner |
| | T ___ R ___ | Section 11 |
| | T ___ R ___ | Grand Haven Twp |
| | T ___ R ___ | |
| 2. Property Controlling
in Section | S ___ T ___ R ___ | |
| | S ___ T ___ R ___ | |
| 3. Miscellaneous
Property in Sec. | S ___ T ___ R ___ | |
| | S ___ T ___ R ___ | |

RECORDED

96 DEC 17 AM 10:41

Richard L. Robinson
REGISTER OF DEEDS
OTTAWA COUNTY, MI

Register of Deeds Stamp & File Number

4. Lot No. _____, Recorded Plat _____
5. Private Claims _____

I, Thomas E. Joiner, in a field survey on January 24, 19 96, do hereby certify that under requirements of P.A. 74, Michigan P.A. of 1970, the corner points mentioned in lines 1 and 2 above were in conformance with regulations and rules therefore as required in the current manual of survey instructions of the United States Department of the Interior, Bureau of Land Management or by a decree of a Court of Law and/or that the corner points mentioned in lines 3, 4 and 5 above were in conformance with the rules of the Michigan Board of Land Surveyors or by a Decree of a Court of Law; established, re-established, monumented, re-monumented, recovered, found as expressed below:

NOTE: Not more than 4 corners, all in the same town and range, may be recorded on this certificate.

	A	B	C	D	E	F	G	H	I	J	K	L	M
2	6	5	4	3	2	1							
3													
4	7	8	9	10	11	12							
5													
6	18	17	16	15	14	13							
7													
8	19	20	21	22	23	24							
9													
10	30	29	28	27	26	25							
11													
12	31	32	33	34	35	36							
13													

A. Description of original monument and accessories and/or subsequent restoration:

May 17th 1832	Liber 7, Page 315	12-28-90
Post Set By Calvin Britain, D.S.	Found Steel Bar in Monument Box	
S 19° W 15' to 12" Red Oak	Q _L Stop Sign NE	55.40
S 87° W 24' to 12" Hemlock	25" Oak SE	37.36
	31" Oak SW	63.51
	Q _L Fire Hydrant NW	60.80


Liber 2, Page 3 1-23-73
Found Ottawa County
Section Corner
26" Oak NW 64.94
30" Oak SW 61.63
30" Oak NE 94.75

B. Description of corner evidence found and/or method applied in restoring or reestablishing corner:

Found 1" Axle Shaft in monument box and accepted as a careful and faithful perpetuation of the original corner. Unable to remove, left as 1" Axle Shaft.
Liber 7, Page 315
Q_L Fire Hydrant NW 60.80
25" Oak SE 37.36

P.A. 345 OTTAWA COUNTY
PEER APPROVED 11-11-96

T. E. Joiner

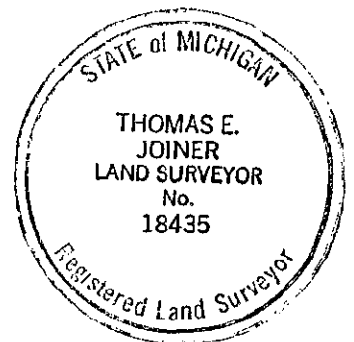

C. Description of monument for corner and accessories established to perpetuate locating the position of the corner:

1" Axle Shaft in monument box		
Q _L Top of Hydrant Operating Bolt	AZ	298° 60.83
Ottawa County Remon tag and nail in SE side Power Pole	AZ	31° 57.75
Ottawa County Remon tag and nail in N side 33" Oak	AZ	123° 37.39
Ottawa County Remon tag and nail in N side 10" Jack Pine	AZ	240° 71.80

\$ 9.00 CORNER
\$ 1.00 PHOTO

Signed by Thomas E. Joiner Date 11-11-96
Surveyor's Michigan License No. 18435