

OTTAWA COUNTY REMONUMENTATION
 LAND CORNER RECORDATION CERTIFICATE
 Filing Requirement of Act 74, Mich. P.A. 1970

RECORDED

94 OCT -7 PM 12:33

Phyllis Anderson
 REGISTER OF DEEDS
 OTTAWA COUNTY, MI

For corners in

<u>OTTAWA</u> (County)	Located In:	Corner Code #
1. Public Land Survey	T <u>7N</u> R <u>16W</u>	<u>K-9, SE Cor.</u>
	T _____ R _____	<u>Section 23</u>
	T _____ R _____	<u>Grand Haven</u>
	T _____ R _____	<u>Township</u>
2. Property Controlling in Section	S _____ T _____ R _____	_____
	S _____ T _____ R _____	_____
3. Miscellaneous Property in Sec.	S _____ T _____ R _____	_____
	S _____ T _____ R _____	_____

Register of Deeds Stamp & File Number

4. Lot No. _____, Recorded Plat _____
 5. Private Claims _____

I, THOMAS E. JOINER in a field survey on MAY 5, 19 94, do hereby certify that under requirements of P.A. 74, Michigan P.A. of 1970, the corner points mentioned in lines 1 and 2 above were in conformance with regulations and rules therefore as required in the current manual of survey instructions of the United States Department of the Interior, Bureau of Land Management or by a decree of a Court of Law and/or that the corner points mentioned in lines 3, 4 and 5 above were in conformance with the rules of the Michigan Board of Land Surveyors or by a Decree of a Court of Law; established, re-established, monumented, re-monumented, recovered, found as expressed below:

A	B	C	D	E	F	G	H	I	J	K	L	M
2	6	5	4	3	2	1						
3												
4	7	8	9	10	11	12						
5												
6	18	17	16	15	14	13						
7												
8	19	20	21	22	23	24						
9												
10	30	29	28	27	26	25						
11												
12	31	32	33	34	35	36						
13												

NOTE: Not more than 4 corners, all in the same town and range, may be recorded on this certificate.

- A. Description of original monument and accessories and/or subsequent restoration:
 05-17-1832 Liber 4, Pg. 312, 04-14-82 Liber 3, Pg. 334, 02-20-79
 Post set by Calvin Britain, D.S. Set cast iron monument Found spike in mon. box
 N20°W 6 12" Beech SE 93.36 8" Sassafras NW 54.33 10" Sassafras
 S18°E 19 7" Hemlock NNE 50.20 18" Sassafras SW 67.29 Telephone Pole
 NW 54.34 10" Sassafras NE 50.23 20" Sassafras
 SW 67.40 36" Oak SE 41.40 Street Sign


- B. Description of corner evidence found and/or method applied in restoring or reestablishing corner:
 Found Cast Iron Monument in Monument Box and accepted as a careful and faithful perpetuation of the position of the original corner.

Liber 4, Pg. 312, 04-14-82
 SE 93.36 8" Sassafras
 SW 67.40 36" Oak

PA. 345 OTTAWA COUNTY
 PEER APPROVED 9/19/94

Walter D. Hedewell

- C. Description of monument for corner and accessories established to perpetuate locating the position of the corner:
 Cast Iron Monument in Monument Box
 O.C. Remon. Tag & Nail in SW side 9" Sassafras Az. 125° 93.36
 O.C. Remon. Tag & Nail in NW side 40" Oak Az. 215° 67.55
 O.C. Remon. Tag & Nail in SW side 12" Sassafras Az. 325° 61.35
 O.C. Remon. Tag & Nail in SE side 18" White Pine Az. 70° 94.49

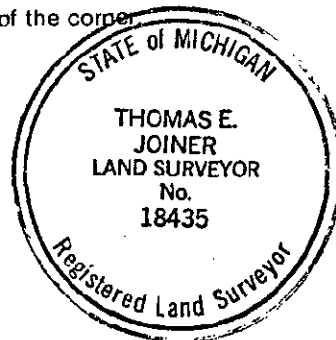

Signed by Thomas E. Joiner Date 9-2-94
 Surveyor's Michigan License No. 18435