OTTAWA COUNTY REMONUMENTATION

LAND CORNER RECORDATION CERTIFICATE

Filing Requirement of Act 74, Mich. P.A. 1970

RECORDED


94 OCT -7 PM 12: 33

OTTAWA (County)	Located In:	Corner Code ##
Public Land Survey	T 7N R16W T R	K-10,W4 Corner Section 25 Grand Haven Twp.

For corners in


Daylie Dillmon REGISTER OF DEEDS OTTAWA COUNTY, MI

2. Property Controlling in Section 3. Miscellaneous Property in Sec.

Register of Deeds Stamp & File Number


___ , Recorded Plat _ 5. Private Claims

1, THOMAS E. VOINER, in a field survey on _ do hereby certify that under requirements of P.A. 74, Michigan P.A. of 1970, the corner points mentioned in lines 1 and 2 above were in conformance with regulations and rules therefore as required in the current manual of survey instructions of the United States Department of the Interior, Bureau of Land Management or by a decree of a Court of Law and/or that the comer points mentioned in lines 3, 4 and 5 above were in conformance with the rules of the Michigan Board of Land Surveyors or by a Decree of a Court of Law; established, re-established, monumented, re-monumented, recovered, found as expressed below:

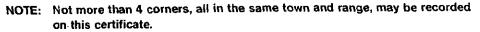

Description of original monument and accessories and/or subsequent restoration: Liber 4,Pg. 27,01-30-80 05-17-1832 Post set by Calvin Britain, D.S. Set cast iron monument S58°W 22 12" Hemlock NW 89.88 Nail in side of P.P. N72°E 20 12" Hemlock NE 65.41 Nail in 7" White Cedar SE 53.48 Nail in 9" Spruce

SE 37.00 Nail in 24" Maple

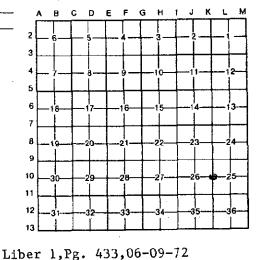

Found reinforcing rod NW 89.32 Power Pole NW 51.25 Street Sign NE 64.88 Nail in 6" Balsam SE 52.94 Nail in 8" Spruce

B. Description of corner evidence found and/or method applied in restoring or reestablishing corner: Found Cast Iron Monument is it works but and accepted as a careful and faithful perpetuation of the position of the original corner.

Liber 4,Pg. 27,01-30-80 NW 89.88 Nail in side P.P. NE 65.41 Nail in side of 7" White Cedar SE 37.00 Nail in side of 24" Maple

Liber 1,Pg. 433,06-09-72 NW 89.32 Power Pole NW 51.25 Street Sign

P.A. 345 OTTAWA COUNTY

PEER APPROVED 9/19 Gordon D. Wedere

C. Description of monument for corner and accessories established to perpetuate locating the position of the corner:

Cast Iron Monument O.C. Remon. Tag & Nail in SE side 9" Cedar O.C. Remon. Tag & Nail in NE side 26" Maple O.C. Remon. Tag & Nail in NE Side 11" Spruce O.C. Remon. Tag & Nail in SW side Power Pole

Az.46° Az. 120° Az. 160° Az. 317°

THOMAS E. JOINER LAND SURVEYOR No. 18435

Signed by ... Surveyor's Michigan License No.

FORM APPROVED BY MICHIGAN STATE BOARD OF LAND SURVEYORS, JAN. 28, 197 REVISED MAY 14, 197 REVISED JAN., 198

Date .