

OTTAWA COUNTY REMONUMENTATION
LAND CORNER RECORDATION CERTIFICATE
 Filing Requirement of Act 74, Mich. P.A. 1970

RECORDED

93 DEC 16 PM 1:00

Phyllis Anderson
 REGISTER OF DEEDS
 OTTAWA COUNTY, MI

For corners in
Ottawa
 (County)

COMMISSION

Located In:

Corner Code #

- | | | |
|------------------------------------|--------------------------|-------------------|
| 1. Public Land Survey | T <u>7N</u> R <u>16W</u> | K-11, N.E. corner |
| | T _____ R _____ | Section 35 |
| | T _____ R _____ | _____ |
| | T _____ R _____ | _____ |
| 2. Property Controlling in Section | S _____ T _____ R _____ | _____ |
| | S _____ T _____ R _____ | _____ |
| 3. Miscellaneous Property in Sec. | S _____ T _____ R _____ | _____ |
| | S _____ T _____ R _____ | _____ |

Register of Deeds Stamp & File Number

4. Lot No. _____, Recorded Plat _____
5. Private Claims _____

	A	B	C	D	E	F	G	H	I	J	K	L	M
2	6	5	4	3	2	1							
3													
4	7	8	9	10	11	12							
5													
6	18	17	16	15	14	13							
7													
8	19	20	21	22	23	24							
9													
10	30	29	28	27	26	25							
11													
12	31	32	33	34	35	36							
13													

I, THOMAS E. JOINER in a field survey on 10-28-1993, do hereby certify that under requirements of P.A. 74, Michigan P.A. of 1970, the corner points mentioned in lines 1 and 2 above were in conformance with regulations and rules therefore as required in the current manual of survey instructions of the United States Department of the Interior, Bureau of Land Management or by a decree of a Court of Law and/or that the corner points mentioned in lines 3, 4 and 5 above were in conformance with the rules of the Michigan Board of Land Surveyors or by a Decree of a Court of Law; established, re-established, monumented, re-monumented, recovered, found as expressed below:

NOTE: Not more than 4 corners, all in the same town and range, may be recorded on this certificate.

A. Description of original monument and accessories and/or subsequent restoration:


Boat Spike in 1" Pipe Liber 4, Pg. 26

- 10" Pine S.W. 79.32
- 10" Pine S.E. 46.32
- 10" Apple E.N.E. 32.70

B. Description of corner evidence found and/or method applied in restoring or reestablishing corner:

Found cast iron monument and accepted as a careful and faithful perpetuation of the position of the original corner.

- Power pole N.W. 72.88
- Power pole S.W. 128.06
- 12" Red Pine W.N.W. 45.94

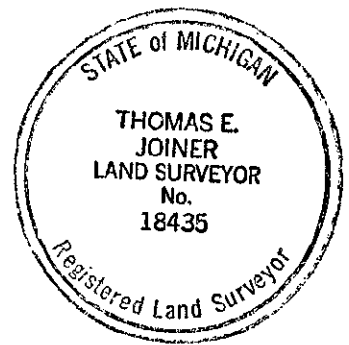

C. Description of monument for corner and accessories established to perpetuate locating the position of the corner:

Cast Iron Monument

- O.C. Remon tag & nail North side 12" Red Pine S. 58° E. 46.66
- O.C. Remon tag & nail South side 12" Red Pine N. 79° W. 45.95
- O.C. Remon tag & nail North side 12" White Pine S. 82° E. 79.20
- O.C. Remon tag & nail West side 15" Red Pine N. 22° W. 84.01

Signed by Thomas E. Joiner Date 11-19-93
 Surveyor's Michigan License No. 18435