

1993

1997

OTTAWA COUNTY REMONUMENTATION
LAND CORNER RECORDATION CERTIFICATE
Filing Requirement of Act 74, Mich. P.A. 1970

RECORDED
93 DEC 16 PM 1:00

Doris Kellman
REGISTER OF DEEDS
OTTAWA COUNTY, MI

For corners in

COMMISSION

Ottawa (County)	Located In:	Corner Code #
1. Public Land Survey	T <u>7N</u> R <u>16W</u>	<u>K-13 S.E. Corner</u> <u>Section 35</u>
	T _____ R _____	_____
	T _____ R _____	_____
	T _____ R _____	_____
2. Property Controlling In Section	S _____ T _____ R _____	_____
	S _____ T _____ R _____	_____
3. Miscellaneous Property in Sec.	S _____ T _____ R _____	_____
	S _____ T _____ R _____	_____
4. Lot No. _____, Recorded Plat _____		
5. Private Claims _____		

Register of Deeds Stamp & File Number

I, THOMAS E. JOINER, in a field survey on 10-28- 19 93, do hereby certify that under requirements of P.A. 74, Michigan P.A. of 1970, the corner points mentioned in lines 1 and 2 above were in conformance with regulations and rules therefore as required in the current manual of survey instructions of the United States Department of the Interior, Bureau of Land Management or by a decree of a Court of Law and/or that the corner points mentioned in lines 3, 4 and 5 above were in conformance with the rules of the Michigan Board of Land Surveyors or by a Decree of a Court of Law; established, re-established, monumented, re-monumented, recovered, found as expressed below:

NOTE: Not more than 4 corners, all in the same town and range, may be recorded on this certificate.

A	B	C	D	E	F	G	H	I	J	K	L	M
2	6	5	4	3	2	1						
3												
4	7	8	9	10	11	12						
5												
6	18	17	16	15	14	13						
7												
8	19	20	21	22	23	24						
9												
10	30	29	28	27	26	25						
11												
12	31	32	33	34	35	36						
13												

A. Description of original monument and accessories and/or subsequent restoration:

R.R. Rail


Liber 1 Pg. 117 10-19-71

N. 80° E. 63.09 Power Pole
 S. 80° E. 60.74 Guy Pole
 South 35.51 4" Cherry
 N. 40° W. 54.21 6" Red Pine
 West 21.00 Iron Pipe

B. Description of corner evidence found and/or method applied in restoring or reestablishing corner:

Found cast iron monument and accepted as a careful and faithful perpetuation of the position of the original corner. Liber 4, Pg. 201 6-25-81

N.E. 63.13 Power Pole
 S.E. 60.79 Guy Pole
 West 21.00 Port Sheldon Corner
 East 100.82 Wolverine Pipeline Sign

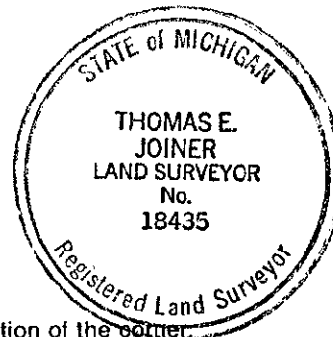

C. Description of monument for corner and accessories established to perpetuate locating the position of the corner:

Cast Iron Monument

O.C. Remon tag & nail Power Pole N. 40° E. 61.74
 O.C. Remon tag & nail Guy Pole S. 50° E. 62.44
 O.C. Remon tag & nail 6" Ash S. 10° E. 33.71
 C_L of Hydrant N. 25° E. 43.90

Signed by Thomas E. Joiner
Surveyor's Michigan License No. 18435

Date 11-4-93