

**SURVEY & REMONUMENTATION**

APR 24 1995

COMMISSION

OTTAWA COUNTY REMONUMENTATION  
**LAND CORNER RECORDATION CERTIFICATE**  
 Filing Requirement of Act 74, Mich. P.A. 1970

RECORDED

94 DEC 14 AM 9:41

*Rhett's*  
 REGISTER OF DEEDS  
 OTTAWA COUNTY, MI

For corners in

Ottawa (County)	Located In:	Corner Code #
1. Public Land Survey	T <u>7N</u> R <u>16W</u>	L-3, S $\frac{1}{2}$ corn. Section 1 Grand Haven Twp
	T _____ R _____	_____
	T _____ R _____	_____
	T _____ R _____	_____
2. Property Controlling in Section	S _____ T _____ R _____	_____
	S _____ T _____ R _____	_____
3. Miscellaneous Property in Sec.	S _____ T _____ R _____	_____
	S _____ T _____ R _____	_____

Register of Deeds Stamp & File Number

4. Lot No. \_\_\_\_\_, Recorded Plat \_\_\_\_\_  
 5. Private Claims \_\_\_\_\_

	A	B	C	D	E	F	G	H	I	J	K	L	M
2	6		5		4		3		2		1		
3													
4	7		8		9		10		11		12		
5													
6	18		17		16		15		14		13		
7													
8	19		20		21		22		23		24		
9													
10	30		29		28		27		26		25		
11													
12	31		32		33		34		35		36		
13													

I, THOMAS E. JOINER, in a field survey on 12-8- 19 94, do hereby certify that under requirements of P.A. 74, Michigan P.A. of 1970, the corner points mentioned in lines 1 and 2 above were in conformance with regulations and rules therefore as required in the current manual of survey instructions of the United States Department of the Interior, Bureau of Land Management or by a decree of a Court of Law and/or that the corner points mentioned in lines 3, 4 and 5 above were in conformance with the rules of the Michigan Board of Land Surveyors or by a Decree of a Court of Law; established, re-established, monumented, re-monumented, recovered, found as expressed below:

**NOTE: Not more than 4 corners, all in the same town and range, may be recorded on this certificate.**

A. Description of original monument and accessories and/or subsequent restoration:

05-18-1832	Liber 1, Pg. 597, 08-21-72
Post set by Calvin Britain, D.S.	Set Cast Iron Monument
8" White Oak is Post	South 0.28 11" Hemlock
	North 3.66 20" Oak
	East 21.80 15" Oak


B. Description of corner evidence found and/or method applied in restoring or reestablishing corner:

Found Cast Iron Monument and accepted as a careful and faithful perpetuation of the position of the original corner.

South 0.28 11" Hemlock  
 North 3.66 20" Oak

P.A. 345 OTTAWA COUNTY  
 PEER APPROVED 12/12/94

*Richard D. Nedrow*

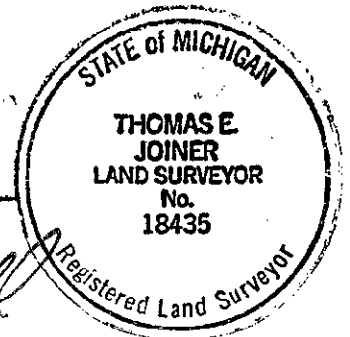

C. Description of monument for corner and accessories established to perpetuate locating the position of the corner:

Cast Iron Monument	
O.C. Remon Tag & Nail in E side 18" Oak	Az. 00° 4.72
O.C. Remon Tag & Nail in N side 20" Oak	Az. 90° 13.63
O.C. Remon Tag & Nail in W side 12" Hemlock	Az. 180° 0.83
O.C. Remon Tag & Nail in S side 15" White Pine	Az. 275° 21.21

Signed by Thomas E. Joiner Date 12-12-94  
 Surveyor's Michigan License No. 18435