

**SURVEY &  
REMONUMENTATION**

APR 05 1996

**OTTAWA COUNTY REMONUMENTATION  
LAND CORNER RECORDATION CERTIFICATE  
Filing Requirement of Act 74, Mich. P.A. 1970**

For corners in **COMMISSION**

Ottawa (County)	Located In:	Corner Code #
1. Public Land Survey	T 7N R 16W	L-5, S $\frac{1}{2}$ corner
	T _____ R _____	Section 12
	T _____ R _____	Grand Haven Twp
	T _____ R _____	
2. Property Controlling in Section	S _____ T _____ R _____	
	S _____ T _____ R _____	
3. Miscellaneous Property in Sec.	S _____ T _____ R _____	
	S _____ T _____ R _____	

**RECORDED**

95 NOV 29 PM 1:39

*Richard B. Robinson*  
REGISTER OF DEEDS  
OTTAWA COUNTY, MI

**Register of Deeds Stamp & File Number**

4. Lot No. \_\_\_\_\_, Recorded Plat \_\_\_\_\_  
5. Private Claims \_\_\_\_\_

	A	B	C	D	E	F	G	H	I	J	K	L	M
2	6	5	4	3	2	1							
3													
4	7	8	9	10	11	12							
5													
6	18	17	16	15	14	13							
7													
8	19	20	21	22	23	24							
9													
10	30	29	28	27	26	25							
11													
12	31	32	33	34	35	36							
13													

I, THOMAS E. JOINER, in a field survey on 11-2-, 19 95, do hereby certify that under requirements of P.A. 74, Michigan P.A. of 1970, the corner points mentioned in lines 1 and 2 above were in conformance with regulations and rules therefore as required in the current manual of survey instructions of the United States Department of the Interior, Bureau of Land Management or by a decree of a Court of Law and/or that the corner points mentioned in lines 3, 4 and 5 above were in conformance with the rules of the Michigan Board of Land Surveyors or by a Decree of a Court of Law; established, re-established, monumented, re-monumented, recovered, found as expressed below:

**NOTE: Not more than 4 corners, all in the same town and range, may be recorded on this certificate.**

A. Description of original monument and accessories and/or subsequent restoration:  
 05-17-1832 Liber 1, Page 597, 08-21-72  
 Post Set By Calvin Britain, D.S. Found 2" Well Point  
 5" Hemlock is Post Set Cast Iron Monument  
 SW 37.95 30" Tree  
 SW 86.50 Power Pole  
 SW 92.97 30" Maple  
 NW 62.45 Telephone Pole  
 NE 87.20 Telephone Pole

B. Description of corner evidence found and/or method applied in restoring or reestablishing corner:  
 Found Cast Iron Monument in Monument Box and accepted as a careful and faithful perpetuation of the position of the original corner.


Liber 1, Page 597, 08-21-72  
 SW 86.50 Power Pole

**P.A. 345 OTTAWA COUNTY**  
**PEER APPROVED** 11/20/95  
*Richard P. McDowell*  
 RDN

C. Description of monument for corner and accessories established to perpetuate locating the position of the corner:

Cast Iron Monument in Monument Box

O.C. Remon Tag & Nail in W side	34" Maple	AZ. 200°	107.15
O.C. Remon Tag & Nail in W side	11" Scotch Pine	AZ. 170°	45.14
O.C. Remon Tag & Nail in E side	11" Scotch Pine	AZ. 22°	41.82
O.C. Remon Tag & Nail in E side	7" Scotch Pine	AZ. 318°	91.78

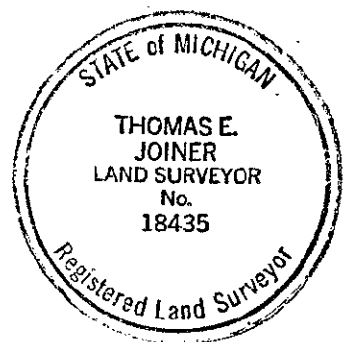

Signed by Thomas E. Joiner Date 11-16-95  
 Surveyor's Michigan License No. 18435