

RECORDED

97 JUL 24 PM 2:25

OTTAWA COUNTY REMONUMENTATION
LAND CORNER RECORDATION CERTIFICATE
Filing Requirement of Act 74, Mich. P.A. 1970

Polina Williams
REGISTER OF DEEDS
OTTAWA COUNTY, MI

For corners in

Ottawa
(County)

Located In:

Corner Code #

- 1. Public Land Survey T 7 R 16 L-9, S $\frac{1}{2}$ corner
 T _____ R _____ Section 24
 T _____ R _____ Grand Haven Twp
- 2. Property Controlling S _____ T _____ R _____
 in Section S _____ T _____ R _____
- 3. Miscellaneous S _____ T _____ R _____
 Property in Sec. S _____ T _____ R _____
- 4. Lot No. _____, Recorded Plat _____
- 5. Private Claims _____

Register of Deeds Stamp & File Number

	A	B	C	D	E	F	G	H	I	J	K	L	M
2	6	5	4	3	2	1							
3													
4	7	8	9	10	11	12							
5													
6	18	17	16	15	14	13							
7													
8	19	20	21	22	23	24							
9													
10	30	29	28	27	26	25							
11													
12	31	32	33	34	35	36							
13													

I, THOMAS E. JOINER in a field survey on November 26, 19 96, do hereby certify that under requirements of P.A. 74, Michigan P.A. of 1970, the corner points mentioned in lines 1 and 2 above were in conformance with regulations and rules therefore as required in the current manual of survey instructions of the United States Department of the Interior, Bureau of Land Management or by a decree of a Court of Law and/or that the corner points mentioned in lines 3, 4 and 5 above were in conformance with the rules of the Michigan Board of Land Surveyors or by a Decree of a Court of Law; established, re-established, monumented, re-monumented, recovered, found as expressed below:

NOTE: Not more than 4 corners, all in the same town and range, may be recorded on this certificate.

A. Description of original monument and accessories and/or subsequent restoration:

L-9
Calvin Britain
May 16, 1832
Corrected line West between Sections 24 & 25 40.21 chains
Set $\frac{1}{4}$ Section post on true line
10" pine is post
No witness's were given

over


B. Description of corner evidence found and/or method applied in restoring or reestablishing corner:

L-9
Found "X" on R X R spike in pavement 0.40 feet below surface. Accepted as a careful and faithful perpetuation of the position of the original corner. Replace R X R spike with O.C. Remon. Cap over 2 feet long steel bar inside monument box.

8" Birch S 38° E 60.26
24" Maple N 67° W 68.11
Concr. Mon. N 40° W 59.58

P.A. 345 OTTAWA COUNTY
PEER APPROVED 12-9-96

T.E.J.

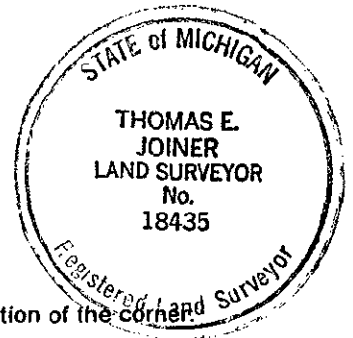

C. Description of monument for corner and accessories established to perpetuate locating the position of the corner:

L-9
Set 2 Foot Long Steel Bar and O.C. Remon. Cap & Set Monument Box
Ottawa County Remon tag and nail in W side 9" Birch AZ 145° Dist. 60.21
Ottawa County Remon tag and nail in E side Power Pole AZ 179° Dist. 50.14
Ottawa County Remon tag and nail in NE side 28" Maple AZ 290° Dist. 67.15
Concrete monument AZ 310° Dist. 59.58

Signed by Thomas E. Joiner
18435

Date 12-6-96

Surveyor's Michigan License No. _____

A. continued

Found nail in tag inscribed "Reference point
M.D.S.H." in NE side 24" Maple AZ 300° Dist 50.88

Found M.D.S.H. Tag and Nail in E
side power pole AZ 179° Dist 50.14

Found P.K. AZ 260° Dist 2.06

Found P.K. AZ 180° Dist 2.00

Liber 3, Page 275
James G. Campbell June 7, 1978
Set "X" on N edge of R X R spike

½" Pine	N		50.0
8" Birch	S	38° E	60.26
24" Maple	N	67° W	68.11
Conc. Mon.	N	40° W	59.58
P.K. Nail	N	80° W	1.30