

OTTAWA COUNTY REMONUMENTATION  
 LAND CORNER RECORDATION CERTIFICATE  
 Filing Requirement of Act 74, Mich. P.A. 1970

RECORDED

94 OCT -7 PM 12:33

For corners in

<u>OTTAWA</u> (County)	Located In:	Corner Code #
1. Public Land Survey	T <u>7N</u> R <u>16W</u>	<u>L-11, S1 Corner</u>
	T _____ R _____	<u>Section 25</u>
	T _____ R _____	<u>Grand Haven Twp</u>
	T _____ R _____	_____
2. Property Controlling in Section	S _____ T _____ R _____	_____
	S _____ T _____ R _____	_____
3. Miscellaneous Property in Sec.	S _____ T _____ R _____	_____
	S _____ T _____ R _____	_____
4. Lot No. _____, Recorded Plat _____		
5. Private Claims _____		

*Robert G. Johnson*  
 REGISTER OF DEEDS  
 OTTAWA COUNTY, MI

SURVEY &  
 REMONUMENTATION

DEC 05 2000

Register of Deeds Stamp & File Number

I, THOMAS E. JOINER in a field survey on MAY 5, 1994, do hereby certify that under requirements of P.A. 74, Michigan P.A. of 1970, the corner points mentioned in lines 1 and 2 above were in conformance with regulations and rules therefore as required in the current manual of survey instructions of the United States Department of the Interior, Bureau of Land Management or by a decree of a Court of Law and/or that the corner points mentioned in lines 3, 4 and 5 above were in conformance with the rules of the Michigan Board of Land Surveyors or by a Decree of a Court of Law; established, re-established, monumented, re-monumented, recovered, found as expressed below:

A	B	C	D	E	F	G	H	I	J	K	L	M
2	6	5	4	3	2							
3												
4	7	8	9	10	11	12						
5												
6	13	17	16	15	14	13						
7												
8	19	20	21	22	23	24						
9												
10	30	29	28	27	26	25						
11												
12	31	32	33	34	35	36						
13												

NOTE: Not more than 4 corners, all in the same town and range, may be recorded on this certificate.

A. Description of original monument and accessories and/or subsequent restoration:

05-17-1832 Post set by Calvin Britain, D.S. N10°E 16 6" Beech S33°W 17 24" Hemlock	Liber 4, Pg. 32, 01-30-80 Set cast iron monument NW 58.47 Nail in 15" Oak SW 45.04 Nail in Twin 16" Maple NE 44.82 Nail in Gaurd Post S 59.48 Nail in 8" White Pine	Liber 3, Pg 275, 08-18-78 1 1/2" Pipe S70°E 133.89 NW House Corn S39°E 73.73 14" Maple S08°E 39.78 NW. Gar. Corn SW 44.99 20" Twin Maple
---	--	---

B. Description of corner evidence found and/or method applied in restoring or reestablishing corner:


Found Cast Iron Monument and accepted as a careful and faithful perpetuation of the position of the original corner.

Liber 4 Pg. 32, 01-30-80 NW 58.47 Nail in side of 15" Oak SW 45.04 Nail is side of Twin 16" Maple S 59.48 Nail in side of 8" White Pine	Liber 3, Pg. 275, 08-18-78 S70°E 133.89 NW House Corner S39°E 73.73 14" Maple S08°E 39.78 NW Garage Corner SW 44.99 20" Twin Maple
--	--

P.A. 345 OTTAWA COUNTY  
 PEER APPROVED 9/19/94

C. Description of monument for corner and accessories established to perpetuate locating the position of the corner:

Cast Iron Monument		
O.C. Remon. Tag & Nail E. side 14" Sassafras	AZ. 190°	23.33
NW Gar. Cor. Conc.	AZ. 175°	39.82
O.C. Remon Tag & Nail in S. side 18" Oak	AZ. 293°	58.30
O.C. Remon. Tag & Nail in N. side 11" Cedar	AZ. 105°	98.41

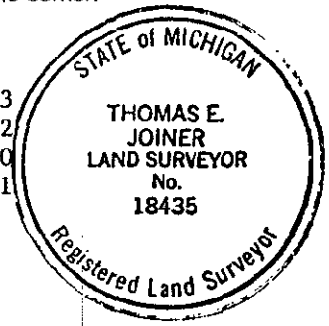

Signed by Thomas E. Joiner Date 9-2-94  
 Surveyor's Michigan License No. 18435