

SURVEY & REMONUMENTATION

DEC 01 1998

**OTTAWA COUNTY REMONUMENTATION
LAND CORNER RECORDATION CERTIFICATE
Filing Requirement of Act 74, Mich. P.A. 1970**

SECTION

For corners in

<u>Ottawa</u> (County)	Located In:	Corner Code #
1. Public Land Survey	T 7 N R 16 W	M-1
	T R	
	T R	
	T R	NE corner
2. Property Controlling in Section	S T R	Section 1
	S T R	Grand Haven Twp.
3. Miscellaneous Property in Sec.	S T R	Common Corner

RECORDED
98 JUL 24 PM 1:46

Steve Lampen
REGISTER OF DEEDS
OTTAWA COUNTY, MI

Register of Deeds Stamp & File Number

4. Lot No. _____, Recorded Plat _____
5. Private Claims _____


I, Steve Lampen, in a field survey on June 4 19 98, do hereby certify that under requirements of P.A. 74, Michigan P.A. of 1970, the corner points mentioned in lines 1 and 2 above were in conformance with regulations and rules therefore as required in the current manual of survey instructions of the United States Department of the Interior, Bureau of Land Management or by a decree of a Court of Law and/or that the corner points mentioned in lines 3, 4 and 5 above were in conformance with the rules of the Michigan Board of Land Surveyors or by a Decree of a Court of Law; established, re-established, monumented, re-monumented, recovered, found as expressed below:

1	A	B	C	D	E	F	G	H	I	J	K	L	M
2	6	5	4	3	2	1							
3													
4	7	8	9	10	11	12							
5													
6	18	17	16	15	14	13							
7													
8	19	20	21	22	23	24							
9													
10	30	29	28	27	26	25							
11													
12	31	32	33	34	35	36							
13													

NOTE: Not more than 4 corners, all in the same town and range, may be recorded on this certificate.

A. Description of original monument and accessories and/or subsequent restoration:

M-1 GLO - Mullett - 1837 West on South side Sec. 31 67.70 to Grand River where raised mound.	Emmet Peck - found stone - 1907 M-13 to M-12 = 2620 M-12 to M-11 = 2620
GLO - Mullett - 1837 78.20 over Grand River 79.30 intersect range line 20 lks. N. of temporary 6 mile post and set corner to T7 & BN. R15 & 16W. Raised a mound.	Carl T. Bowen - stone - 1954 Survey shows iron on Section line 869 ft South of M-12
	Emmet Peck - Survey in Section 6, T7N, R15W A-1 to A-2 = 40.78 ch. A-1 to C-1 = 80.23 ch.

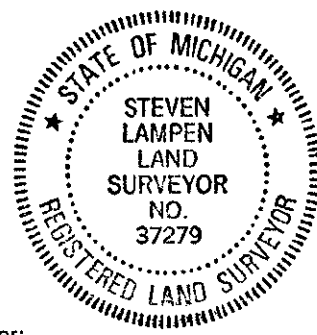

B. Description of corner evidence found and/or method applied in restoring or reestablishing corner:

M-1 Did not find stone.

Re-established North and South position by measuring M-12 - M-13 equal to M-12 - M-11 as measured by Peck. measure = 2617.95, Peck = 2620

Re-established East and West position by extending M-12 and a found pipe stake 869.5' South of M-12 set by Bowen in 1954. This position measures reasonable with the Peck survey of Section 6, T7N, R15W. See sketch on back.

Set an Ottawa County Remonumentation iron and cap and is accepted as a careful and faithful re-establishment of the position of the original corner.

C. Description of monument for corner and accessories established to perpetuate locating the position of the corner:

M-1 Ottawa County Remonumentation iron and cap

Remonumentation tag in West side	Twin 10"-16" Maple	198°	23.85
Remonumentation tag in West	Twin 16" Ash	343°	68.10
Remonumentation tag in South	Triple 10" Maple	238°	18.27
Remonumentation tag in South	8" Poplar	124°	37.38

PA. 345 OTTAWA COUNTY
APPROVED 6-15-98
YDN

Signed by Steven Lampen Date JULY 20, 1998
Surveyor's Michigan License No. 37279

FORM APPROVED BY MICHIGAN STATE BOARD OF LAND SURVEYORS, JAN 1985
REVISED MAY 24 1985
REVISED JAN. 1983
ADAPTED FOR WORD PROCESSING MARCH, 1993

\$11.00 CORNERS RECEIVED #1011

SURVEY &
REMONUMENTATION

DEC 01 1998

SECTION

