

SURVEY & REMONUMENTATION

APR 24 1995

COMMISSION

OTTAWA COUNTY REMONUMENTATION LAND CORNER RECORDATION CERTIFICATE Filing Requirement of Act 74, Mich. P.A. 1970

RECORDED

96 DEC 14 AM 9:42

Phyllis Robinson
REGISTER OF DEEDS
OTTAWA COUNTY, MI

For corners in

OTTAWA (County)	Located In:	Corner Code #
Public Land Survey	T <u>7N</u> R <u>16W</u>	M-3, SE Corner Section 1 Grand Haven Twp.
	T _____ R _____	_____
	T _____ R _____	_____
	T _____ R _____	_____
Property Controlling in Section	S _____ T _____ R _____	_____
Miscellaneous	S _____ T _____ R _____	_____
Property in Sec.	S _____ T _____ R _____	_____

Register of Deeds Stamp & File Number

Lot No. _____ Recorded Plat _____
Private Claims _____

	A	B	C	D	E	F	G	H	I	J	K	L	M
2	6		5		4		3		2		1		
3													
4	7		8		9		10		11		12		
5													
6	18		17		16		15		14		13		
7													
8	19		20		21		22		23		24		
9													
10	30		29		28		27		26		25		
11													
12	31		32		33		34		35		36		
13													

THOMAS E. JOINER, in a field survey on 10-28-94, 1994, do hereby certify that under requirements of P.A. 74, Michigan P.A. of 1970, the corner points mentioned in lines 1 and 2 above were in conformance with regulations and rules therefore as required in the current manual of survey instructions of the United States Department of the Interior, Bureau of Land Management or by a decree of a Court of Law and/or that the corner points mentioned in lines 3, 4 and 5 above were in conformance with the rules of the Michigan Board of Land Surveyors or by a Decree of a Court of Law; established, re-established, monumented, re-monumented, recovered, found as expressed below:

NOTE: Not more than 4 corners, all in the same town and range, may be recorded on this certificate.

Description of original monument and accessories and/or subsequent restoration:	
05-16-1832	Liber 3, Pg. 379, 07-27-79
Post set by Calvin Britain, D.S.	Set Cast Iron Monument
S59°W 25.20" Pine	NW 39.90 30" Oak
N65°W 6.20" Pine	NE 59.70 48" Oak
	SE 69.60 18" Oak
	SE 46.50 Telephone Pole

Liber 1, Pg. 597, 08-21-72
Found iron pipe
W. 24.80 Street Sign
N45°E 49.83 22" Oak
SE 46.93 Power Pole
SE 69.58 12" Oak

Description of corner evidence found and/or method applied in restoring or reestablishing corner:


Found Cast Iron Monument in Monument Box and accepted as a careful and faithful perpetuation of the position of the original corner.

Liber 3, Pg. 379, 07-27-79
NW 39.90 30" Oak
SE 69.60 18" Oak

Liber 1, Pg. 597, 08-21-72
SE 69.58 12" Oak

P.A. 345 OTTAWA COUNTY
PEER APPROVED 12/12/94

Richard D. Nedewell

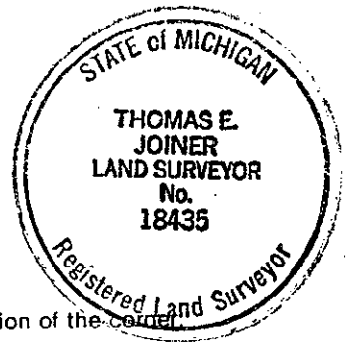

Description of monument for corner and accessories established to perpetuate locating the position of the corner:

Cast Iron Monument in Monument Box

CL Top Operating Nut on Hydrant	Az. 40°	51.13
O.C. Remon. Tag & Nail in W side 24" Oak	Az. 150°	70.37
O.C. Remon. Tag & Nail in E side 12" White Oak	Az. 192°	90.92
O.C. Remon. Tag & Nail in NE side 30" Oak	Az. 318°	41.12

Signed by Thomas E. Joiner
Surveyor's Michigan License No. 18435

Date 11-28-94