

SURVEY & REMONUMENTATION

APR 24 1995

COMMISSION

OTTAWA COUNTY REMONUMENTATION LAND CORNER RECORDATION CERTIFICATE Filing Requirement of Act 74, Mich. P.A. 1970

RECORDED

94 DEC 14 AM 9:42

Edydis Robinson
REGISTER OF DEEDS
OTTAWA COUNTY, MI

For corners in
OTTAWA

(County)

Located In:

Corner Code ~~##~~

- | | | |
|------------------------------------|--------------------------|-----------------------------|
| 1. Public Land Survey | T <u>7N</u> R <u>16W</u> | M-4, E $\frac{1}{2}$ Corner |
| | T _____ R _____ | Section <u>12</u> |
| | T _____ R _____ | Grand Haven Twp. |
| | T _____ R _____ | _____ |
| 2. Property Controlling in Section | S _____ T _____ R _____ | _____ |
| | S _____ T _____ R _____ | _____ |
| 3. Miscellaneous Property in Sec. | S _____ T _____ R _____ | _____ |
| | S _____ T _____ R _____ | _____ |

Register of Deeds Stamp & File Number

4. Lot No. _____, Recorded Plat _____
5. Private Claims _____

	A	B	C	D	E	F	G	H	I	J	K	L	M
2	6	5	4	3	2	1							
3													
4	7	8	9	10	11	12							
5													
6	18	17	16	15	14	13							
7													
8	19	20	21	22	23	24							
9													
10	30	29	28	27	26	25							
11													
12	31	32	33	34	35	36							
13													

I, THOMAS E. JOINER in a field survey on 10-28- 19 94, do hereby certify that under requirements of P.A. 74, Michigan P.A. of 1970, the corner points mentioned in lines 1 and 2 above were in conformance with regulations and rules therefore as required in the current manual of survey instructions of the United States Department of the Interior, Bureau of Land Management or by a decree of a Court of Law and/or that the corner points mentioned in lines 3, 4 and 5 above were in conformance with the rules of the Michigan Board of Land Surveyors or by a Decree of a Court of Law; established, re-established, monumented, re-monumented, recovered, found as expressed below:

NOTE: Not more than 4 corners, all in the same town and range, may be recorded on this certificate.

A. Description of original monument and accessories and/or subsequent restoration:

05-16-1832	Liber 3, Pg. 379, 07-27-79	Liber 1, Pg. 597, 08-21-72
Post set by Calvin Britain, D.S.	Set Cast Iron Monument	Found Iron
N42°W 40 30" Pine	NNE 67.25 Telephone Pole	W 36.20 $\frac{1}{2}$ " Iron
S75°W 24 28" Pine	E. 58.30 36" Oak	E 27.70 $\frac{1}{2}$ " Iron
	NE 43.74 12" Oak	NW 69.55 18" Pine
	N. 7.50 Rob. Twp. Cor.	NE 42.20 12" Oak
		W 44.95 24" Oak


3. Description of corner evidence found and/or method applied in restoring or reestablishing corner:

Found Cast Iron Monument in Monument Box and accepted as a careful and faithful perpetuation of the position of the original corner.

Liber 3, Pg. 379, 07-27-79
East 58.30 36" Oak
North 7.50 Robinson Township corner

Liber 1, Pg. 597, 08-21-72
West 44.95 24" Oak

P.A. 345 OTTAWA COUNTY
PEER APPROVED 12/12/94

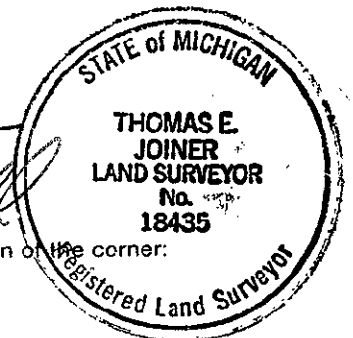

C. Description of monument for corner and accessories established to perpetuate locating the position of the corner:

Cast Iron Monument in Monument Box

O.C. Remon. Tag & Nail in S side 12" Triple Oak	Az. 40°	80.35
O.C. Remon. Tag & Nail in SW side 42" Oak	Az. 92°	58.04
O.C. Remon. Tag & Nail in N side 22" White Oak	Az. 222°	52.62
O.C. Remon. Tag & Nail in NE side 17" white oak	Az. 320°	75.48
Cast Iron Monument, Robinson Twp. corner, A-4	Az. 00°	7.50

Signed by Thomas E. Joiner

Date 11-28-94

Surveyor's Michigan License No. 18435