

SURVEY & REMONUMENTATION

APR 24 1995

COMMISSION

**OTTAWA COUNTY REMONUMENTATION
LAND CORNER RECORDATION CERTIFICATE
Filing Requirement of Act 74, Mich. P.A. 1970**

RECORDED

94 DEC 15 AM 11:47

D. J. ...
REGISTER OF DEEDS
OTTAWA COUNTY, MI

For corners in

<u>Ottawa</u> (County)	Located In:	Corner Code #:
	Grand Haven Twp.	
1. Public Land Survey	T <u>7N</u> R <u>16W</u>	<u>M-7</u>
	T ___ R ___	<u>NE Corner</u>
	T ___ R ___	<u>Section 24</u>
	T ___ R ___	_____
2. Property Controlling in Section	S ___ T ___ R ___	_____
	S ___ T ___ R ___	_____
3. Miscellaneous Property in Sec.	S ___ T ___ R ___	_____
	S ___ T ___ R ___	_____

Register of Deeds Stamp & File Number

4. Lot No. _____, Recorded Plat _____
5. Private Claims _____

	A	B	C	D	E	F	G	H	I	J	K	L	M
2	6		5		4		3		2		1		
3													
4	7		8		9		10		11		12		
5													
6	18		17		16		15		14		13		
7													
8	19		20		21		22		23		24		
9													
10	30		29		28		27		26		25		
11													
12	31		32		33		34		35		36		
13													

I, Carl P. Englert, in a field survey on October 1994, do hereby certify that under requirements of P.A. 74, Michigan P.A. of 1970, the corner points mentioned in lines 1 and 2 above were in conformance with regulations and rules therefore as required in the current manual of survey instructions of the United States Department of the Interior, Bureau of Land Management or by a decree of a Court of Law and/or that the corner points mentioned in lines 3, 4 and 5 above were in conformance with the rules of the Michigan Board of Land Surveyors or by a Decree of a Court of Law; established, re-established, monumented, re-monumented, recovered, found as expressed below:

NOTE: Not more than 4 corners, all in the same town and range, may be recorded on this certificate.

A. Description of original monument and accessories and/or subsequent restoration:
M-7 corner common to Sections 13 & 24
Original gov't corner set May, 1832 by Calvin Britain D.S.
Set corner to Section 13 & 24
Hemlock 18" S72°W 8 Links
Hemlock 10" N29°W 32 Links
LCRC Liber 2, Page 777 (2/5/75)
M-7 Cast Iron Monument
15" Maple NW 50.04'
15" Maple WNW 82.46'
P.Pole NNW 82.16'
St. Sign E 36.68'
NW Corner Section 19
T7N, R15W N 51.33'
T. Pole SW 48.88'


B. Description of corner evidence found and/or method applied in restoring or reestablishing corner:
M-7 corner common to Sections 13 & 24
Found 4" Harrison Cast Iron Mon.
Found 15" Maple WNW 82.46'
Found NW corner Sec. 19-7-15 N 51.36

PA. 345 OTTAWA COUNTY
PEER APPROVED 12/12/94
Brandon D. Newell

Accepted as a careful and faithful perpetuation of the original position of the corner.

C. Description of monument for corner and accessories established to perpetuate locating the position of the corner:
M-7 corner common to Sections 13 & 24
4" broken Harrison Cast Iron Monument 7'+/- W. of Road E, Placed Mon. Box
O.C. Remon. Tag & Nail in N. side 16" Maple N71°W 83.01'
O.C. Remon. Tag & Nail in N.E. side P.P. N63°W 96.17'
O.C. Remon. Tag & Nail in E. side P.P. N31°W 167.78'
O.C. Remon. Tag & Nail in S.W. side P.P. N41°E 52.88'
O.C. Remon. Tag & Nail in S. side 15" Pine N76°E 73.97'
T7N, R15W corner NORTH 51.36'

Signed by Carl P. Englert Date 12/11/94
Surveyor's Michigan License No. 18987

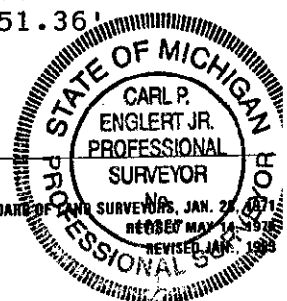

FORM APPROVED BY MICHIGAN STATE BOARD OF LAND SURVEYORS, JAN. 23, 1971
REVISED MAY 14, 1978
REVISED JAN. 1983