

SURVEY & REMONUMENTATION

FEB 27 1998

Ottawa County Remonumentation
LAND CORNER RECORDATION CERTIFICATE
 Filing Requirement of Act 74, Mich. P.A. 1970

SECTION
 For corners in

<u>Ottawa</u> (County)	Located in:	Corner Code #
1. Public Land Survey	T <u>7N</u> R <u>16W</u>	<u>M-9</u>
	T _____ R _____	<u>SE corner</u>
	T _____ R _____	<u>Section 24-7-16</u>
	T _____ R _____	<u>Grand Haven Twp</u>
2. Property Controlling in Section	S _____ T _____ R _____	_____
	S _____ T _____ R _____	_____
3. Miscellaneous Property in Sec.	S _____ T _____ R _____	_____
	S _____ T _____ R _____	_____
4. Lot No. _____, Recorded Plat _____		
5. Private Claims _____		

RECORDED

97 DEC -8 AM 11:28

Sam R. Hill
 REGISTER OF DEEDS
 OTTAWA COUNTY, MI

Register of Deeds Stamp & File Number

I, THOMAS E. JOINER, in a field survey on 11-22- 19 97, do hereby certify that under requirements of P.A. 74, Michigan P.A. of 1970, the corner points mentioned in lines 1 and 2 above were in conformance with regulations and rules therefore as required in the current manual of survey instructions of the United States Department of the Interior, Bureau of Land Management or by a decree of a Court of Law and/or that the corner points mentioned in lines 3, 4 and 5 above were in conformance with the rules of the Michigan Board of Land Surveyors or by a Decree of a Court of Law; established, re-established, monumented, re-monumented, recovered, found as expressed below:

A	B	C	D	E	F	G	H	I	J	K	L	M
2	6	5	4	3	2	1						
3												
4	7	8	9	10	11	12						
5												
6	18	17	16	15	14	13						
7												
8	19	20	21	22	23	24						
9												
10	30	29	28	27	26	25						
11												
12	31	32	33	34	35	36						
13												

NOTE: Not more than 4 corners, all in the same town and range, may be recorded on this certificate.

A. Description of original monument and accessories and/or subsequent restoration:

M-9 Calvin Britain D.S. 1832	Liber 4, Page 312
Set corner to Sections 24 & 25	4-9-82
30" Pine N55°W 18 links	Set cast iron monument
15" White Oak S25°W 29 links	20" Pine NNE 82.50
	20" Pine NE 104.26
	Telephone pole NW 59.81
	26" Oak SE 72.88
	Robinson corner North 21.92


B. Description of corner evidence found and/or method applied in restoring or reestablishing corner:

M-9 Found cast iron monument in monument box and accepted as a careful and faithful perpetuation of the position of the original corner.

Liber 4, Page 312
 Found R.R. spike from old ties, set cast iron monument
 20" Pine NE 104.26
 26" Oak SE 72.88
 Robinson corner North 21.92

P.A. 345 OTTAWA COUNTY
 PEER APPROVED 12-1-97

YDN

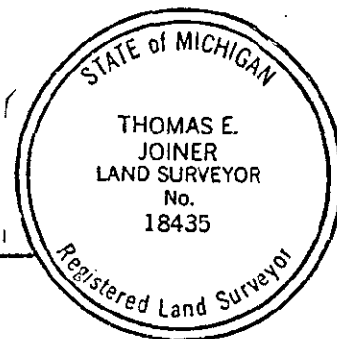

C. Description of monument for corner and accessories established to perpetuate locating the position of the corner:

M-9 Found cast iron monument in box

Ottawa County Remon. Tag & Nail in W side 26" Oak	AZ 161°	Dist 78.30'
Ottawa County Remon. Tag & Nail in SW side Power Pole	AZ 324°	Dist 63.62'
Cut cross in center of 2.80' x 0.70' concrete head wall	AZ 196°	Dist 58.26'
SW corner block building	AZ 51°	Dist 169.61'
Robinson corner	AZ 0°	Dist 21.92'
M-9 on center line 144th and 1.80' North of M-45		

\$1.00 PHOTO

Signed by Thomas E. Joiner Date 12-1-97
 Surveyor's Michigan License No. 18435