

SURVEY & REMONUMENTATION

APR 24 1995

OTTAWA COUNTY REMONUMENTATION LAND CORNER RECORDATION CERTIFICATE Filing Requirement of Act 74, Mich. P.A. 1970

RECORDED

94 DEC 14 AM 9:42

For corners in **COMMISSION**

Robert Holman
REGISTER OF DEEDS
OTTAWA COUNTY, MI

OTTAWA (County)	Located In:	Corner Code #
Public Land Survey	T <u>7N</u> R <u>16W</u>	M-10, E $\frac{1}{2}$ Corner Section 25 Grand Haven Twp.
	T _____ R _____	
	T _____ R _____	
	T _____ R _____	
Property Controlling in Section	S _____ T _____ R _____	
	S _____ T _____ R _____	
Miscellaneous Property in Sec.	S _____ T _____ R _____	
	S _____ T _____ R _____	

Register of Deeds Stamp & File Number

Lot No. _____, Recorded Plat _____
Private Claims _____

	A	B	C	D	E	F	G	H	I	J	K	L	M
2	6	5	4	3	2								
3													
4	7	8	9	10	11	12							
5													
6	18	17	16	15	14	13							
7													
8	19	20	21	22	23	24							
9													
10	30	29	28	27	26	25							
11													
12	31	32	33	34	35	36							
13													

Thomas E. Joiner, in a field survey on 10-28- 19 94,
do hereby certify that under requirements of P.A. 74, Michigan P.A. of 1970, the corner points mentioned in lines 1 and 2 above were in conformance with regulations and rules therefore as required in the current manual of survey instructions of the United States Department of the Interior, Bureau of Land Management or by a decree of a Court of Law and/or that the corner points mentioned in lines 3, 4 and 5 above were in conformance with the rules of the Michigan Board of Land Surveyors or by a Decree of a Court of Law; established, re-established, monumented, re-monumented, recovered, found as expressed below:

NOTE: Not more than 4 corners, all in the same town and range, may be recorded on this certificate.

Description of original monument and accessories and/or subsequent restoration:
05-15-1832 Liber 4, Pg. 32, 01-30-80

Post set by Calvin Britain, D.S. Set cast iron monument
N36°W 17 10" Hemlock SE 93.50 Nail in side Power Pole
S68°W 30 14" Hemlock SW 51.05 Nail in side Power Pole
NE 91.36 Nail in side 18" Red Oak
N. 20.56 Robinson Twp. Corner


Liber 3, Pg. 274, 08-18-78
Found plow share
N. 20.56 Rob. Twp. Corner
N20°E 91.00 14" Black Oak
S25°W 87.28 12" Red Pine
S61°W 44.46 16" Juniper
S82°W 110.52 12" Juniper

Description of corner evidence found and/or method applied in restoring or reestablishing corner:

Found Cast Iron Monument and accepted as a careful and faithful perpetuation of the position of the original corner.

Liber 4, Pg. 32, 01-30-80	Liber 3, Pg. 247, 08-18-78
SW 51.05 Nail in side of power pole	N 20° E 91.00 14" Black Oak
NE 91.36 Nail in side of 18" Red Oak	S 25° W 87.28 12" Red Pine
North 20.56 Robinson Twp. corner	S 61° W 44.46 16" Juniper
SE 93.50 Nail in side of power pole	S 82° W 110.52 12" Juniper

P.A. 345 OTTAWA COUNTY
PEER APPROVED 12/12/94

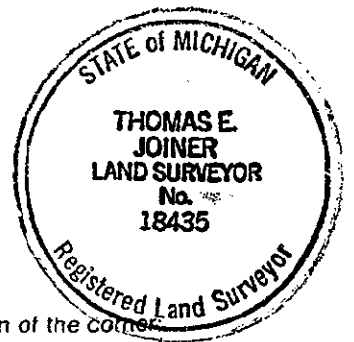

Description of monument for corner and accessories established to perpetuate locating the position of the corner:

Cast Iron Monument

O.C. Remon. Tag & Nail in E side 14" Red Pine	Az. 205°	86.88
O.C. Remon. Tag & Nail in SE side 18" Juniper	Az. 240°	43.82
O.C. Remon. Tag & Nail in NE side of power pole	Az. 135°	93.63
O.C. Remon. Tag & Nail W side 22" Oak	Az. 20°	91.11
Cast Iron Monument, Robinson Twp Corner, A-10	Az. 0°	20.56

Signed by Thomas E. Joiner
Surveyor's Michigan License No. 18435

Date 11-28-94