

**OTTAWA COUNTY REMONUMENTATION  
LAND CORNER RECORDATION CERTIFICATE  
Filing Requirement of Act 74, Mich. P.A. 1970**

For corners in

<u>Ottawa</u> (County)	Located In:	Corner Code #/
1. Public Land Survey	T <u>7N</u> R <u>16W</u>	H-7, S $\frac{1}{2}$ corner Section 15 Grand Haven Twp
	T _____ R _____	
	T _____ R _____	
	T _____ R _____	
2. Property Controlling in Section	S _____ T _____ R _____	
	S _____ T _____ R _____	
3. Miscellaneous Property in Sec.	S _____ T _____ R _____	<i>Seg. #2 pm</i>
	S _____ T _____ R _____	
4. Lot No. _____, Recorded Plat _____		
5. Private Claims _____		

**RECORDED**

96 DEC 17 AM 10:44

*Rhonda Anderson*  
REGISTER OF DEEDS  
OTTAWA COUNTY, MI

**Register of Deeds Stamp & File Number**

I, Thomas E. Joiner, in a field survey on October 31, 19 96, do hereby certify that under requirements of P.A. 74, Michigan P.A. of 1970, the corner points mentioned in lines 1 and 2 above were in conformance with regulations and rules therefore as required in the current manual of survey instructions of the United States Department of the Interior, Bureau of Land Management or by a decree of a Court of Law and/or that the corner points mentioned in lines 3, 4 and 5 above were in conformance with the rules of the Michigan Board of Land Surveyors or by a Decree of a Court of Law; established, re-established, monumented, re-monumented, recovered, found as expressed below:

A	B	C	D	E	F	G	H	I	J	K	L	M
2	6	5	4	3	2							
3												
4	7	8	9	10	11	12						
5												
6	18	17	16	15	14	13						
7												
8	19	20	21	22	23	24						
9												
10	30	29	28	27	26	25						
11												
12	31	32	33	34	35	36						
13												

**NOTE: Not more than 4 corners, all in the same town and range, may be recorded on this certificate.**

**A. Description of original monument and accessories and/or subsequent restoration:**

Set cast iron monument inscribed "Section Corner" Liber 4, Page 71 6-5-80	Iron Pipe Liber 3, Page 39 3-10-76	Cast iron monument inscribed "Section Corner" Remon Liber 1, Page 279 11-19-93
15" Oak N 31.51	16" Oak N 31.51	9" Oak S 03° E 62.72
12" Spruce NE 36.95	12" Spruce NE 36.95	14" Cherry N 55° W 65.49
20" Oak SE 29.93	20" Oak SE 29.93	8" Spruce S 48° E 57.39
RxR Sign SW 25.95		20" Oak N 03° W 31.00


OVER

**B. Description of corner evidence found and/or method applied in restoring or reestablishing corner:**

Found Cast Iron Monument and accepted as a careful and faithful perpetuation of the position of the original corner. Set Ottawa County Remon. cap over two foot long steel bar, directly over the cast iron monument. Ottawa County Road Commission will place a monument box over the cap and bar when Buchanan Street is resurfaced. This corner is part of the Road Commission improvement project.

Remon. Liber 1, Page 279  
9" Oak S 03° E 62.72  
14" Cherry N 55° W 65.49  
8" Spruce S 48° E 57.39

P.A. 345 OTTAWA COUNTY  
PEER APPROVED 11-11-96  
*[Signature]*

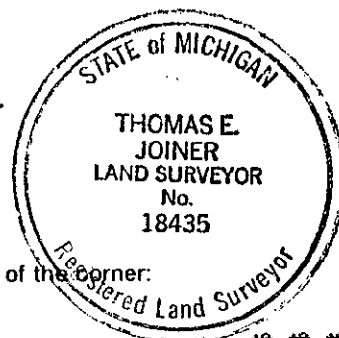

**C. Description of monument for corner and accessories established to perpetuate locating the position of the corner:**

Remon Cap and Bar								
Ottawa County Remon tag and nail in East side	9" Oak	AZ 177°	Dist. 62.72	\$ 1.00 PHOTO	\$ 11.00 CORNER			
Ottawa County Remon tag and nail in South side	14" Cherry	AZ 305°	Dist. 65.49					
Ottawa County Remon tag and nail in North side	8" Spruce	AZ 132°	Dist. 57.39					
Ottawa County Remon tag and nail in West side	12" Jack Pine	AZ 340°	Dist. 66.83					

Signed by Thomas E. Joiner Date 11-11-96  
Surveyor's Michigan License No. 18435