

# SURVEY & REMONUMENTATION

FEB 27 1998

SECTION

## OTTAWA COUNTY REMONUMENTATION LAND CORNER RECORDATION CERTIFICATE Filing Requirement of Act 74, Mich. P.A. 1970

For corners in

<u>Ottawa</u> (County)	Located in:	Corner Code #
1. Public Land Survey	T 8N R 13W	A-3 (SW, 6)
	T ___ R ___	Wright Twp.
	T ___ R ___	Common cor.
	T ___ R ___	to M-3,
2. Property Controlling in Section	S ___ T ___ R ___	Polkton Twp.
	S ___ T ___ R ___	
3. Miscellaneous Property in Sec.	S ___ T ___ R ___	
	S ___ T ___ R ___	

RECORDED

97 DEC -8 AM 11:30

*Ray Schiele*  
REGISTER OF DEEDS  
OTTAWA COUNTY, MI

Register of Deeds Stamp & File Number

4. Lot No. \_\_\_\_\_, Recorded Plat \_\_\_\_\_  
5. Private Claims \_\_\_\_\_

I, Donald W. Schiele, in a field survey on 11-29, 1997 do hereby state that under requirements of P.A. 74, Michigan P.A. of 1970, the corner points mentioned in lines 1 and 2 above were in conformance with regulations and rules therefore as required in the current manual of survey instructions of the United States Department of the Interior, Bureau of Land Management or by a decree of a Court of Law and /or that the corner points mentioned in lines 3, 4 and 5 above were in conformance with the rules of the Michigan Board of Land Surveyors or by a Decree of a Court of Law; established, re-established, monumented, recovered, found as expressed below:

NOTE: Not more than 2 corners, all in the same town and range, may be recorded on this certificate.

A	B	C	D	E	F	G	H	I	J	K	L	M
1												
2	6	5	4	3	2	1						
3												
4	7	8	9	10	11	12						
5												
6	18	17	16	15	14	13						
7												
8	19	20	21	22	23	24						
9												
10	30	29	28	27	26	25						
11												
12	31	32	33	34	35	36						
13												

A. Description of original monument and accessories and/or subsequent restoration:

A-3 Corner common to Sections 6 & 7, Wright Twp. and Sections 1 & 12, Polkton Twp., T8N, R14W.  
Original Government Corner Record: L.C.R.C. recorded in Liber 5, Page 320, 8-9-88:  
Set post cor secs. 1 & 12 from which an Elm 34 in dia bears S43W 13 lks dist & a Beech 9 " " " N87W 6 " " " BRASS PLUG  
Post T.P. SSE. 86.35  
John Mullett, Deputy Surveyor 7" MAPLE SW. 51.25  
April 7, 1837 6" BLK. CHERRY WSW. 92.30


B. Description of corner evidence found and/or method applied in restoring or reestablishing corner:

A-3 Found PK nail on surface of asphalt road, and accepted as a careful and faithful perpetuation of the position of the original corner.  
Found PK nail & washer in NW side of Power Pole N40°30'E 90.47'(E)  
NE corner, concrete block building S21°30'W 85.70'(E)  
Found PK nail in NW side of 8" Maple S42°W 51.30'(E)  
Centerline 9" Cherry S69°W 92.3'

RA. 345 OTTAWA COUNTY

PEER APPROVED 12-1-97

*Donald W. Schiele*

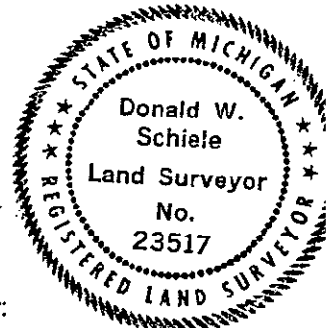

C. Description of monument for corner and accessories established to perpetuate locating the position of the corner:

A-3 Removed PK nail & replaced with 3/4" X 24" Steel Bar with Ottawa County Remon Cap, 2" below surface of asphalt road in Monument Box.  
Set Ottawa County Remon Tag & nail in SE side of Power Pole N40°30'E 90.44'(E)  
Set Ottawa County Remon Tag & nail in North side of 10" Elm S73°E 105.22'(E)  
NE corner, concrete block building S21°30'W 85.70'(E)  
Set Ottawa County Remon Tag & nail in SE side of 8" Maple S42°W 51.42'(E)  
Set Ottawa County Remon Tag & nail in North side of 9" Cherry S69°W 92.27'(E)  
Centerline asphalt road North & South, 0.7' East  
Centerline gravel road East, 1' South  
Centerline gravel road West, 1' North

\$ 9.00 CORNER  
\$ 1.00 PHOTO

Signed by Donald W. Schiele  
Surveyor's Michigan License No. 23517

Date Dec 4, 1997