

SURVEY & REMONUMENTATION

OCT 07 1996

COMMISSION

OTTAWA COUNTY REMONUMENTATION LAND CORNER RECORDATION CERTIFICATE Filing Requirement of Act 74, Mich. P.A. 1970

For corners in

Ottawa

(County)

Located In:
Wright Twp.

Corner Code #

- | | | |
|------------------------------------|--------------------------|------------------------|
| 1. Public Land Survey | T <u>8N</u> R <u>13W</u> | B-3 |
| | T ___ R ___ | N $\frac{1}{4}$ Corner |
| | T ___ R ___ | Section <u>7</u> |
| | T ___ R ___ | _____ |
| 2. Property Controlling in Section | S ___ T ___ R ___ | _____ |
| | S ___ T ___ R ___ | _____ |
| 3. Miscellaneous Property in Sec. | S ___ T ___ R ___ | _____ |
| | S ___ T ___ R ___ | _____ |

RECORDED

96 AUG 26 PM 2: 03

Elizabeth K. Kilduff
REGISTER OF DEEDS
OTTAWA COUNTY, MI

Register of Deeds Stamp & File Number

4. Lot No. _____, Recorded Plat _____
5. Private Claims _____

I, Carl P. Englert, Jr., in a field survey on November 17/19 95 do hereby state that under requirements of P.A. 74, Michigan P.A. of 1970, the corner points mentioned in lines 1 and 2 above were in conformance with regulations and rules therefore as required in the current manual of survey instructions of the United States Department of the Interior, Bureau of Land Management or by a decree of a Court of Law and/or that the corner points mentioned in lines 3, 4 and 5 above were in conformance with the rules of the Michigan Board of Land Surveyors or by a Decree of a Court of Law; established, re-established, monumented, recovered, found as expressed below:

NOTE: Not more than 2 corners, all in the same town and range, may be recorded on this certificate.

	A	B	C	D	E	F	G	H	I	J	K	L	M
1													
2		6		5		4		3		2		1	
3		●											
4		7		8		9		10		11		12	
5													
6		18		17		16		15		14		13	
7													
8		19		20		21		22		23		24	
9													
10		30		29		28		27		26		25	
11													
12		31		32		33		34		35		36	
13													

A. Description of original monument and accessories and/or subsequent restoration:

- B-3 $\frac{1}{4}$ Corner common to Sections 6 & 7
Original Gov't Corner Set September, 1838
by Enoch Hammele
Set $\frac{1}{4}$ Section Post
Beech 16" S 34° E 10 Links
Beech 14" N 83° W 11 Links

LCRC Liber 3, Page 64, 1/14/1976
Stone Fc. Post S. 31.4'
Fd "T" Iron & Fc. Post S. 31.4'
Set Cast Iron Mon.
26" Maple NNW 27.55'
22" Maple NW 44.57'
6" Maple SW 42.35'

See Other Side

B. Description of corner evidence found and/or method applied in restoring or reestablishing corner:

- B-3 $\frac{1}{4}$ Corner common to Sections 6 & 7
Found 4" Cast Iron Monument with Broken Top in CL of Gravel Road
Found 26" Maple NNW 27.55'±
Found 22" Maple NW 44.57'± no nails
Found 8" Maple SW 42.35'±
On occupation lines North and South

P.A. 345 OTTAWA COUNTY
PEER APPROVED 12/11/95

Robert D. Nedewell R.D. 71


Accepted as a careful and faithful perpetuation of the position of the original corner.

C. Description of monument for corner and accessories established to perpetuate locating the position of the corner:

- B-3 $\frac{1}{4}$ Corner common to Sections 6 & 7
4" Cast Iron Monument with top broken off 2" below grade in CL Gravel Road
Ottawa County Remonumentation tag and nail in E. Side 12" Elm S 10° E 41.88'
Ottawa County Remonumentation tag and nail in E. Side 30" Maple North 26.42'
Ottawa County Remonumentation tag and nail in NE Side 18" Maple N 60° W 60.23'
Ottawa County Remonumentation tag and nail in S. Side 18" Maple S 62° W 42.30'

Signed by Carl P. Englert Jr.
Surveyor's Michigan License No. 18987

Date 12/8/1995

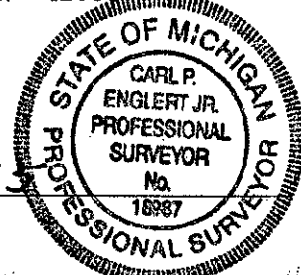

B - 3 T 8 N, R 13 W
CRC Liber 6, Page 102, 10/30/1990
Found CIM
26" Maple N. 27.40'
24" Maple NW 44.35'
7" Maple SW 42.27'
5" Clump Elm S. 43.67'

**SURVEY &
REMONUMENTATION**

OCT 07 1996

COMMISSION

\$ 11.00 CORNER
\$ 1.00 PHOTO
\$ 1.00 PHOTO