

SURVEY & REMONUMENTATION

FEB 27 1998

SECTION

**OTTAWA COUNTY REMONUMENTATION
LAND CORNER RECORDATION CERTIFICATE
Filing Requirement of Act 74, Mich. P.A. 1970**

For corners in

<u>Ottawa</u> (County)	Located In:	Corner Code #
1. Public Land Survey	T <u>8N</u> R <u>13W</u>	B-5 (S $\frac{1}{4}$, 7) Wright Twp.
	T ___ R ___	_____
	T ___ R ___	_____
	T ___ R ___	_____
2. Property Controlling in Section	S ___ T ___ R ___	_____
	S ___ T ___ R ___	_____
3. Miscellaneous Property in Sec.	S ___ T ___ R ___	_____
	S ___ T ___ R ___	_____

RECORDED


97 DEC -8 AM 11:30

Ray Schultz
REGISTER OF DEEDS
OTTAWA COUNTY, MI

Register of Deeds Stamp & File Number

4. Lot No. _____, Recorded Plat _____
5. Private Claims _____

I, Donald W. Schiele, in a field survey on 11-24, 1997 do hereby state that under requirements of P.A. 74, Michigan P.A. of 1970, the corner points mentioned in lines 1 and 2 above were in conformance with regulations and rules therefore as required in the current manual of survey instructions of the United States Department of the Interior, Bureau of Land Management or by a decree of a Court of Law and/or that the corner points mentioned in lines 3, 4 and 5 above were in conformance with the rules of the Michigan Board of Land Surveyors or by a Decree of a Court of Law, established, re-established, monumented, recovered, found as expressed below.

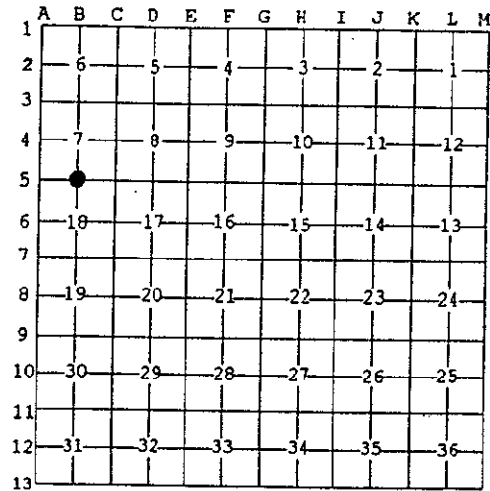

NOTE: Not more than 2 corners, all in the same town and range, may be recorded on this certificate.

A. Description of original monument and accessories and/or subsequent restoration:

B-5 1/4 corner common to Sections 7 & 18, Wright Twp.
Original Government Corner Record: L.C.R.C. recorded in Liber 3,
Page 176, 9-16-77:
Set qr sec post B-5 1/2" Rod
Post SE 22.31 Basswood Stump
Sugar 15 S22E 24 NE 15.81 8" Ash
Do 6 N37W 15 S 15.20 Tw. Oak
Enoch Hammele, Deputy Surveyor, for SW 25.90 Hickory
Rasselas Whitcomb, Deputy Surveyor
Between 9-18 and 9-26, 1838


P.A. 345 OTTAWA COUNTY

PEER APPROVED 12-1-97

YDZ

B. Description of corner evidence found and/or method applied in restoring or reestablishing corner:

B-5 Found 1/2" X 18" Capped Iron #18987 at ground level, and accepted as a careful and faithful perpetuation of the position of the original corner. Found 1' diameter rock on West edge of Capped Iron #18987.
Found nail & tag in NW side of 9" Twin Ash N39°E 15.52' (E)
Found nail & tag in North side of 12" Oak S66°E 22.05' (E)
Found nail in South side of 6" Oak S62°30'E 22.22' (E)
Found nail & tag in SE side of 12" Oak S48°30'E 13.41' (E)
Found nail & tag in West side of 10" Twin Oak S15°30'E 15.11' (E)
Found nail in West side of 10" Twin Oak S15°30'E 15.11' (E)

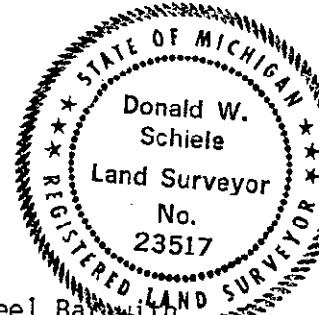

C. Description of monument for corner and accessories established to perpetuate locating the position of the corner:

B-5 Removed 1/2" X 18" Capped Iron #18987, and replaced with 3/4" X 36" Steel Bar with Ottawa County Remon Cap, at ground level. Replaced 1' diameter rock along West edge of Remon Cap.
Set Ottawa County Remon Tag & nail in SE side of 9" Twin Ash N39°E 15.42' (E)
Set Ottawa County Remon Tag & nail in North side of 12" Oak S66°E 22.05' (E)
Set Ottawa County Remon Tag & nail in East side of 10" Twin Oak S15°30'E 14.98' (E)
Set Ottawa County Remon Tag & nail in North side of 8" Poplar S76°W 44.95' (E)
On fence line to North
Fence line to South, 1'± West
Centerline old roadbed to West, 3'± South

49.00 CORNER
41.00 PHOTO

Signed by Donald W. Schiele
Surveyor's Michigan License No. 23517

Date Dec. 1, 1997