



Part A., continued:

L.C.R.C. recorded in L.4, P.234, 10-22-81 by Thomas E. Joiner:

C-2 Set Cast Iron Monument  
 Power Pole ESE 70.76  
 Fence Post East 26.80  
 Fence Post SW 25.10

From survey recorded in L.4, certified Survey Maps of Ottawa County, P.522, 1-9-80 by Gordon D. Nederveld:

W1/4 cor. Sec. 5, T8N, R13W  
(C.I.Mon.)

PK in N. side P. Pole S.S.E. 70.73'  
 PK in S. side P. Pole W. 135.87'  
 PK in N.W. side Fence Post S.W. 31.70'


FEB 24 2000

From Ottawa County Surveyor records (undated):

SECTION

C-2

Corner lost run straight 2 to 3 (2 is NE corner Section 6 and 3 is SE corner Section 6)  
Stake in Corner

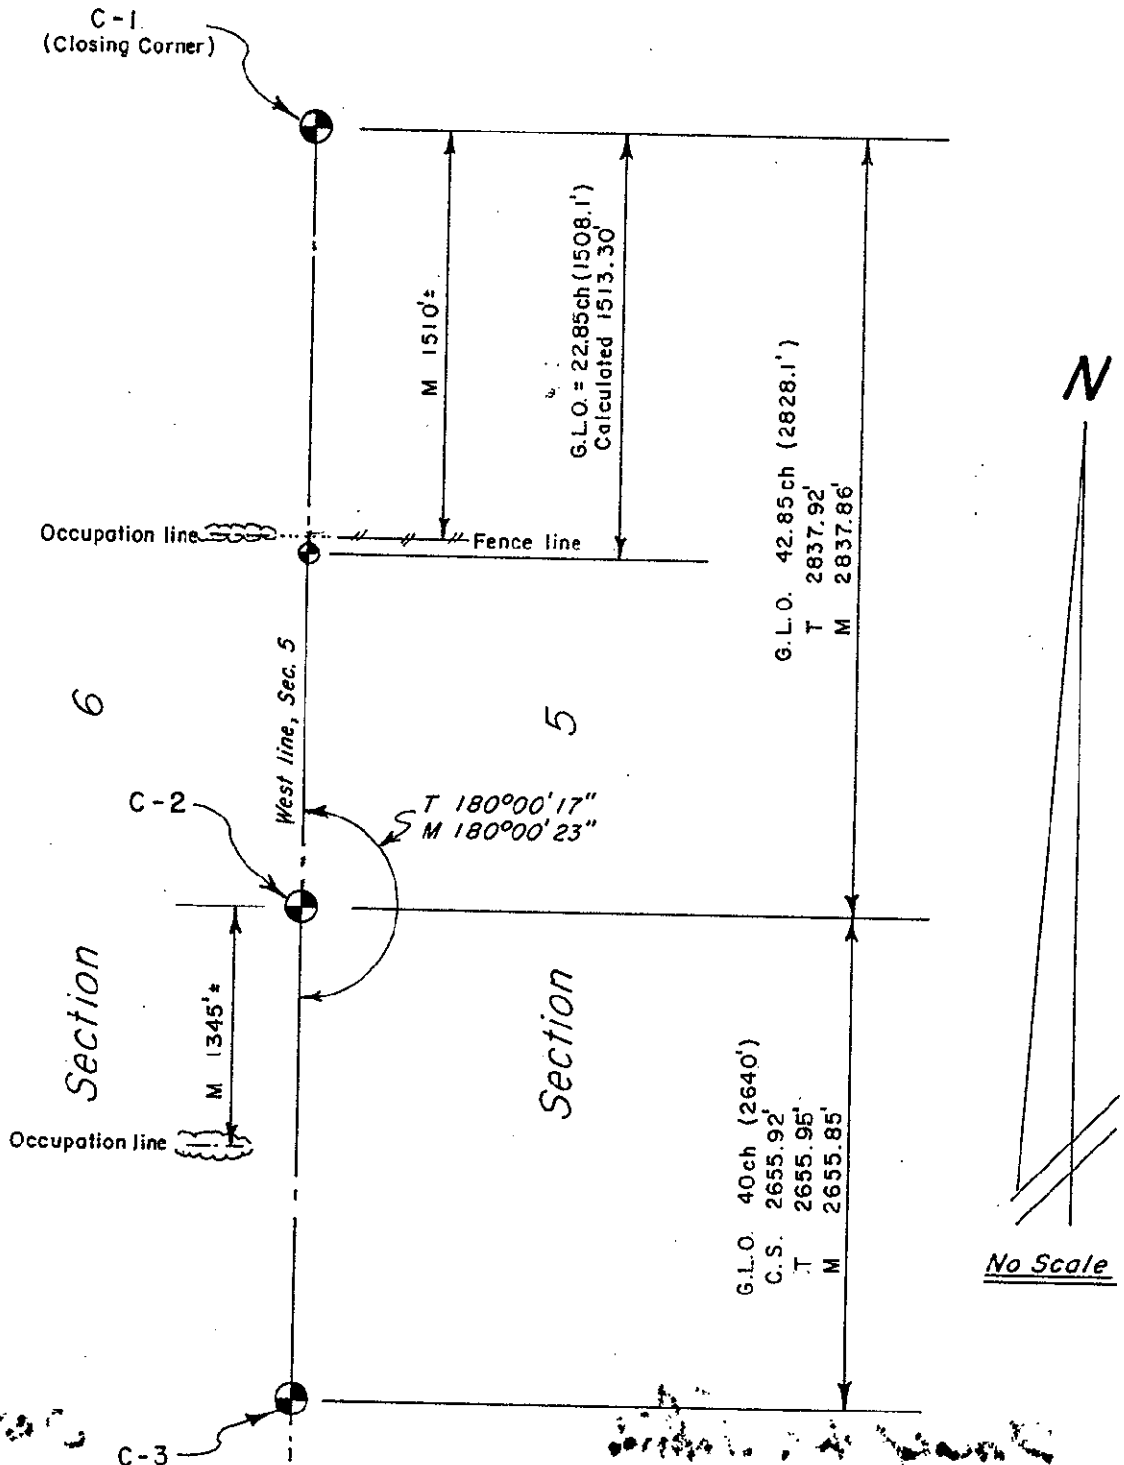

C. S. = Calculated from L.4, P. 522, Certified Survey Maps of Ottawa Co., by Nederveld & Jonker, surveyed 8-7-79.  
 T = Tru-Line Surveying, surveyed 1990.