

**SURVEY & REMONUMENTATION**

DEC 16 1996

COMMISSION


**OTTAWA COUNTY REMONUMENTATION  
LAND CORNER RECORDATION CERTIFICATE  
Filing Requirement of Act 74, Mich. P.A. 1970**

For corners in

Ottawa (County)	Located In:	Corner Code #
1. Public Land Survey	T 8N R 13W	C-3 (NE,7) Wright Twp.
	T _____ R _____	_____
	T _____ R _____	_____
	T _____ R _____	_____
2. Property Controlling in Section	S _____ T _____ R _____	_____
	S _____ T _____ R _____	_____
3. Miscellaneous Property in Sec.	S _____ T _____ R _____	_____
	S _____ T _____ R _____	_____
4. Lot No. _____, Recorded Plat _____		
5. Private Claims _____		

**RECORDED**  
96 NOV 14 AM 11:21  
*Sylvia Kallman*  
REGISTER OF DEEDS  
OTTAWA COUNTY, MI  
**Register of Deeds Stamp & File Number**

I, Donald W. Schiele, in a field survey on September 16, 19 96, do hereby certify that under requirements of P.A. 74, Michigan P.A. of 1970, the corner points mentioned in lines 1 and 2 above were in conformance with regulations and rules therefore as required in the current manual of survey instructions of the United States Department of the Interior, Bureau of Land Management or by a decree of a Court of Law and/or that the corner points mentioned in lines 3, 4 and 5 above were in conformance with the rules of the Michigan Board of Land Surveyors or by a Decree of a Court of Law, established, re-established, monumented, re-monumented, recovered, found as expressed below:

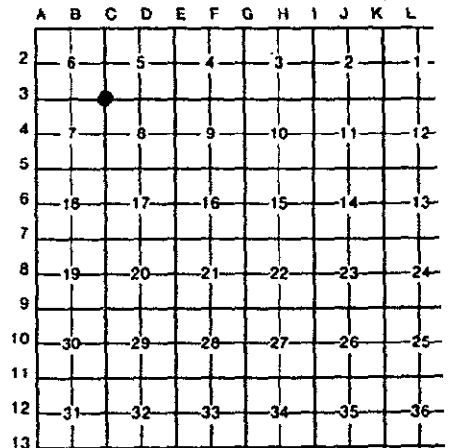

**NOTE: Not more than 4 corners, all in the same town and range, may be recorded on this certificate.**

A. Description of original monument and accessories and/or subsequent restoration:  
C-3 Corner common to Sections 5,6,7 & 8, Wright Twp.

Original Government Corner Record:  
Set post cor to sec 5,6,7 & 8  
Post  
Sugar 14 N67E 31  
Beech 12 S19W 32  
Enoch Hammele, Deputy Surveyor  
Between 9-18 and 9-26, 1838

L.C.R.C. recorded in Liber 3, Page 64, 3-29-76  
Set cast iron Mon.  
P. pole NE 78.54'  
C/L St. sign NW 47.70'

(SEE REVERSE)

B. Description of corner evidence found and/or method applied in restoring or reestablishing corner:

C-3 Found Cast Iron Monument inscribed "Ottawa County Section Corner", 8 1/2" below surface of asphalt pavement in Monument Box, and accepted as a careful and faithful perpetuation of the position of the original corner.

Found nail in SE side of Power Pole N40°E 78.52' (E)  
Found nail in NW side of Power Pole N40°E 78.58' (E)  
Found PK nail in NW side of Fence Post (post leaning SW, base 1'± NE) S49°W 46.19' (E)  
Found Cast Iron Monument West 2658.15' (E)  
Found Cast Iron Monument (broken) North 2655.85' (E)  
Centerline North & South asphalt road 1.2' East  
On centerline gravel road East  
Centerline gravel road West, 2'± North

PA. 345 OTTAWA COUNTY  
PEER APPROVED 10-21-96


*[Signature]*

C. Description of monument for corner and accessories established to perpetuate locating the position of the corner:

C-3 Cast Iron Monument inscribed "Ottawa County Section Corner", 8 1/2" below surface of asphalt pavement in Monument Box.

Set Ottawa County Remon Tag & nail in NW side of Power Pole N40°E 78.57' (E)  
Set Ottawa County Remon Tag & nail in South side of corner Fence Post N79°30'E 95.65' (E)  
Set Ottawa County Remon Tag & nail in West side of 28" Willow S09°E 217.00' (E)  
Set Ottawa County Remon Tag & nail in North side of 30" Osage Orange S84°W 198.82' (E)  
Centerline North & South asphalt road, 1.2' East  
On centerline gravel road East  
Centerline gravel road West, 2'± North

Signed by Donald W. Schiele  
Surveyor's Michigan License No. 23517

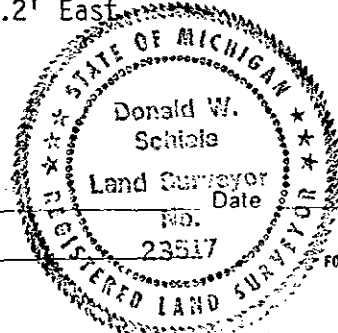

October 21, 1996

SURVEY &  
REMONUMENTATION

DEC 1 5 1996

COMMISSION

Section A., continued:

C-3

Certified Survey recorded in Liber 2, Page 731, 2-20-76:

Mon. Box C/L--C/L

P.P. N.E. 78.6'

Yield Sign E.N.E. 67.9'

St. Sign N.W. 47.75'

Fence Post S.W. 45.0'

S1/4 Post (Mon. Box in gravel) West 2657.88'

Certified Survey recorded in Liber 4, Page 522, 1-23-80:

Cast Iron Monument

PK in N.W. side fence cor. S.W. 46.17'

Nail in N.W. side P. Pole N.E. 78.61'

St. Sign N.W. 47.83'

Calculated distance, SW cor., Sec. 5 to W 1/4 cor., Sec. 5 2655.92'