

**SURVEY &
REMONUMENTATION**

RECORDED

DEC 01 1993

OTTAWA COUNTY REMONUMENTATION
LAND CORNER RECORDATION CERTIFICATE
Filing Requirement of Act 74, Mich. P.A. 1970

93 NOV 11 AM 11:55

COMMISSION

Richard Robinson
REGISTER OF DEEDS
OTTAWA COUNTY, MI

For corners in

Ottawa

(County)

Located In:

Corner Code ##

- | | | |
|---------------------------------------|--------------------------|--|
| 1. Public Land Survey | T <u>8N</u> R <u>13W</u> | <u>C-6 (W$\frac{1}{4}$, 17)</u>
<u>Wright Twp.</u> |
| | T _____ R _____ | _____ |
| | T _____ R _____ | _____ |
| | T _____ R _____ | _____ |
| 2. Property Controlling
in Section | S _____ T _____ R _____ | _____ |
| | S _____ T _____ R _____ | _____ |
| 3. Miscellaneous
Property in Sec. | S _____ T _____ R _____ | _____ |
| | S _____ T _____ R _____ | _____ |

Register of Deeds Stamp & File Number

4. Lot No. _____, Recorded Plat _____
5. Private Claims _____

I, Donald W. Schiele in a field survey on November 6, 1993, do hereby certify that under requirements of P.A. 74, Michigan P.A. of 1970, the corner points mentioned in lines 1 and 2 above were in conformance with regulations and rules therefore as required in the current manual of survey instructions of the United States Department of the Interior, Bureau of Land Management or by a decree of a Court of Law and/or that the corner points mentioned in lines 3, 4 and 5 above were in conformance with the rules of the Michigan Board of Land Surveyors or by a Decree of a Court of Law; established, re-established, monumented, re-monumented, recovered, found as expressed below:

NOTE: Not more than 4 corners, all in the same town and range, may be recorded on this certificate.

	A	B	C	D	E	F	G	H	I	J	K	L	M
2	6		5		4		3		2		1		
3													
4	7		8		9		10		11		12		
5													
6	18		17		16		15		14		13		
7													
8	19		20		21		22		23		24		
9													
10	30		29		28		27		26		25		
11													
12	31		32		33		34		35		36		
13													


A. Description of original monument and accessories and/or subsequent restoration:
C-6 corner common to Sections 17 & 18, Wright Twp.
L.C.R.C. recorded in Liber 3, Page 95, 6-18-76. L.C.R.C. recorded in Liber 3, Page 270, 6-12-78.
Pk in sde P. Pole SSW 124.13' C.I.M.
Nail in sde 12" Apple ENE 34.70' 20" Apple N29°E 61.27'
Nail in sde 12" Apple NE 61.27' P. Pole S88°E 37.09'
On C.L. B.T. road and in line with N. End Culv. S78°E 24.50'
power line to East. S. End Culv. S30°E 46.86'

B. Description of corner evidence found and/or method applied in restoring or reestablishing corner:
C-6 Found Cast Iron Monument inscribed "Ottawa County Section Corner" in Monument Box and accepted as a careful and faithful perpetuation of the position of the original corner.
On Centerline asphalt road North & South and in line with Power Line to East
Found Tag # 2442 and double-headed nail in North side of Power Pole S88°E 37.19'
North end 12" Concrete Culvert -- found chiseled "X" S79°E 24.50'
South end 12" Concrete Culvert -- found chiseled "X" S30°E 46.87'
Found PK nail in West side of Power Pole S18°W 124.14'

C. Description of monument for corner and accessories established to perpetuate locating the position of the corner:
C-6 C.I.M. inscribed "Ottawa County Section Corner" 3" below surface in Monument Box.
Set Ottawa County Remon Tag & nail in North side of Power Pole S88°E 37.13'
Chiseled "X" in North end 12" Concrete Culvert S79°E 24.50'
Chiseled "X" in South end 12" Concrete Culvert S30°E 46.87'
Set Ottawa County Remon Tag & nail in SW side of 3" Pine S24°E 92.77'
Set Ottawa County Remon Tag & nail in East side of Power Pole S18°W 124.16'
On Centerline asphalt road North and South
On Centerline Power Pole line to East
Occupation line to West, 10'± North

Signed by Donald W. Schiele
Surveyor's Michigan License No. 23517

Date Nov. 8, 1993

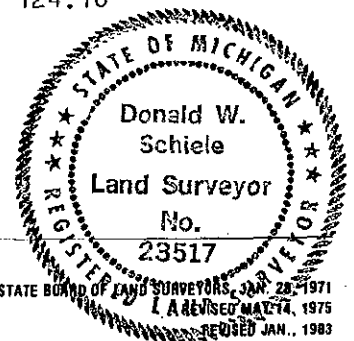

FORM APPROVED BY MICHIGAN STATE BOARD OF LAND SURVEYORS, JAN. 28, 1971
L.A. REVISED MAY 74, 1975
REVISED JAN., 1983