

SURVEY & REMONUMENTATION

APR 25 1995

COMMISSION

OTTAWA COUNTY REMONUMENTATION
 LAND CORNER RECORDATION CERTIFICATE
 Filing Requirement of Act 74, Mich. P.A. 1970

RECORDED

94 DEC -8 PM 12:38

For corners in

Ottawa (County)	Located In:	Corner Code #
1. Public Land Survey	T <u>8N</u> R <u>13W</u>	<u>C-8 (W$\frac{1}{4}$, 20)</u> <u>Wright Twp.</u>
	T _____ R _____	_____
	T _____ R _____	_____
	T _____ R _____	_____
2. Property Controlling in Section	S _____ T _____ R _____	_____
	S _____ T _____ R _____	_____
3. Miscellaneous Property in Sec.	S _____ T _____ R _____	_____
	S _____ T _____ R _____	_____

Daphne Coleman
 REGISTER OF DEEDS
 OTTAWA COUNTY, MI

Register of Deeds Stamp & File Number

4. Lot No. _____, Recorded Plat _____
 5. Private Claims _____

	A	B	C	D	E	F	G	H	I	J	K	L	M
2	6		5		4		3		2		1		
3													
4	7		8		9		10		11		12		
5													
6	18		17		16		15		14		13		
7													
8	19		20		21		22		23		24		
9													
10	30		29		28		27		26		25		
11													
12	31		32		33		34		35		36		
13													


I, Donald W. Schiele, in a field survey on October 13, 19 94, do hereby certify that under requirements of P.A. 74, Michigan P.A. of 1970, the corner points mentioned in lines 1 and 2 above were in conformance with regulations and rules therefore as required in the current manual of survey instructions of the United States Department of the Interior, Bureau of Land Management or by a decree of a Court of Law and/or that the corner points mentioned in lines 3, 4 and 5 above were in conformance with the rules of the Michigan Board of Land Surveyors or by a Decree of a Court of Law; established, re-established, monumented, re-monumented, recovered, found as expressed below:

NOTE: Not more than 4 corners, all in the same town and range, may be recorded on this certificate.

A. Description of original monument and accessories and/or subsequent restoration:
 C-8 $\frac{1}{4}$ corner common to Sections 19 & 20, Wright Twp.
 Original Government Corner Record: L.C.R.C. recorded in Liber 2, Page 79, 3-23-73
 Set qr sec post between Sec. 19 & 20. Fnd. 1/2" Iron Pipe
 Post House Corner ENE 61.39'
 Sugar 24 N88E 9 30" Maple NW 28.24'
 Do 8 S84W 18 30" Maple SW 36.42'
 Enoch Hammele, Deputy Surveyor Transformer Pole SSE 73.70'
 Between 9-18 and 9-26, 1838 30" Chestnut SE 52.71'

(SEE REVERSE)

3. Description of corner evidence found and/or method applied in restoring or reestablishing corner:
 C-8 Found Cast Iron Monument inscribed "Section Corner", 3" below surface in Monument Box, and accepted as a careful and faithful perpetuation of the position of the original corner.
 Centerline 17" Juniper N58°30'E 35.9'
 NW corner, footing to House # 16374 N88°E 61.51'
 Centerline 35" Chestnut S36°E 53.9'
 Found nail & Tag # 14091 in East side of Power Pole S25°E 74.23'
 Found PK nail in West side of Power Pole S25°E 73.86'

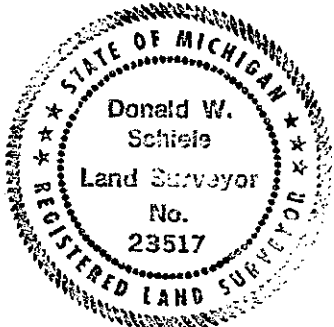

C. Description of monument for corner and accessories established to perpetuate locating the position of the corner:
 C-8 Cast Iron Monument inscribed "Section Corner", 3" below surface in Monument Box.
 Set Ottawa County Remon Tag & nail in NW side of 17" Juniper N58°30'E 35.91'
 NW corner, footing to House # 16374 N88°E 61.51'
 SW corner, footing to House # 16374 S61°E 70.35'
 Set Ottawa County Remon Tag & nail in SW side of 35" Chestnut S36°E 53.92'
 Set Ottawa County Remon Tag & nail in West side of Power Pole S25°E 74.07'
 NE corner, Pole Building S38°W 181.57'
 On centerline asphalt road North & South

Richard P. Medley
 P.A. 345 OTTAWA COUNTY
 PEER APPROVED 10/17/94

Signed by Donald W. Schiele

Date Oct. 17, 1994

Surveyor's Michigan License No. 23517

PART A. continued:

L.C.R.C. recorded in Liber 3, Page 41, 3-16-76
C-8

Metal Disc. - Ottawa County Section Corner
Nail & Cap in side of 24" Chestnut S30°E 52.92'
Nail in side of 24" Maple S30°W 37.58'
Nail in side of 10" Juniper N45°E 35.91'

L.C.R.C. recorded in Liber 3, Page 58, 3-29-76
C-8

Set cast iron Mon.
10" Juniper NE 35.88'
30" Chestnut SE 53.91'
P. pole SSE 74.28'
32" Maple SW 37.55'
32" Maple NW 29.76'