

SURVEY & REMONUMENTATION

APR 25 1995

COMMISSION

OTTAWA COUNTY REMONUMENTATION LAND CORNER RECORDATION CERTIFICATE Filing Requirement of Act 74, Mich. P.A. 1970

RECORDED

94 DEC -8 PM 12:39

D. J. Schiele
REGISTER OF DEEDS
OTTAWA COUNTY, MI

For corners in

Ottawa (County)	Located In:	Corner Code #
Public Land Survey	T <u>8N</u> R <u>13W</u>	<u>C-9 (SW, 20)</u> <u>Wright Twp.</u>
	T _____ R _____	_____
	T _____ R _____	_____
	T _____ R _____	_____
Property Controlling in Section	S _____ T _____ R _____	_____
	S _____ T _____ R _____	_____
Miscellaneous Property in Sec.	S _____ T _____ R _____	_____
	S _____ T _____ R _____	_____

Register of Deeds Stamp & File Number

Lot No. _____, Recorded Plat _____
Private Claims _____

Donald W. Schiele, in a field survey on October 13, 19 94,
hereby certify that under requirements of P.A. 74, Michigan P.A. of 1970, the corner points mentioned
in lines 1 and 2 above were in conformance with regulations and rules therefore as required in the
current manual of survey instructions of the United States Department of the Interior, Bureau of Land
Management or by a decree of a Court of Law and/or that the corner points mentioned in lines 3, 4 and 5
above were in conformance with the rules of the Michigan Board of Land Surveyors or by a Decree of a
Court of Law; established, re-established, monumented, re-monumented, recovered, found as
expressed below:

NOTE: Not more than 4 corners, all in the same town and range, may be recorded on this certificate.

	A	B	C	D	E	F	G	H	I	J	K	L	M
2	6	5	4	3	2	1							
3													
4	7	8	9	10	11	12							
5													
6	18	17	16	15	14	13							
7													
8	19	20	21	22	23	24							
9													
10	30	29	28	27	26	25							
11													
12	31	32	33	34	35	36							
13													

Description of original monument and accessories and/or subsequent restoration:
C-9 corner common to Sections 19, 20, 29 & 30, Wright Twp.
Original Government L.C.R.C. recorded in Liber 3,
Corner Record: Page 41, 3-16-76
Set corner post to Sec. Metal Disc - Ottawa County
9, 20, 29 & 30. Section Corner
Post South corner of Hse 3955 N40°E 101.37'
Beech 6 N26W 19 Nail in side of Power Pole N35°W 63.13'
Sugar 12 S54E 28 High point on Large Stone N60°E 44.19'
Enoch Hammele, Deputy Surveyor
Between 9-18 and 9-26, 1838

L.C.R.C. recorded in
Liber 3, Page 56, 3-29-76
Set cast iron Mon.
P. pole NW 63.15'
12" Maple NE 78.10'
C/L St. sign SE 31.71'
P. pole SW 84.90'

Description of corner evidence found and/or method applied in restoring or reestablishing corner:

C-9 Found Cast Iron Monument with top broken off, 6" below surface in Monument Box, and
accepted as a careful and faithful perpetuation of the position of the original corner.
Found nail in NW side of 20" Maple N22°E 78.02'
SW corner, footing to House # 3955 N37°E 101.26'
Found nail in West side of Power Pole S27°30'W 84.94'
Found nail in SW side of Power Pole N36°W 62.72'
Found nail in NE side of Power Pole N36°W 63.11'
Found PK nail in NE side of Power Pole N36°W 63.05'

P.A. 345 OTTAWA COUNTY

PEER APPROVED 10/17/94

Abdoy D. Hedewald

Description of monument for corner and accessories established to perpetuate locating the position of the corner:


C-9 Cast Iron Monument with top broken off, 6" below surface in Monument Box.
Set Ottawa County Remon Tag & nail in West side of 20" Maple N22°E 78.15'
Set Ottawa County Remon Tag & nail in NW side of Power Pole N29°30'E 58.31'
SW corner, footing to House # 3955 N37°E 101.26'
Set Ottawa County Remon Tag & nail in West side of Power Pole S27°30'W 84.90'
Set Ottawa County Remon Tag & nail in NE side of Power Pole N36°W 63.11'

On Centerline asphalt road North
On Centerline asphalt road tangents East & West
Centerline of East & West asphalt road curve, 1' North
Centerline gravel road South, 1' East

Signed by Donald W. Schiele

Date Oct. 17, 1994

Surveyor's Michigan License No. 23517

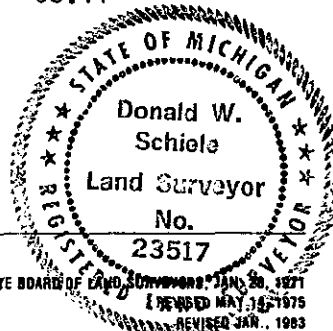

FORM APPROVED BY MICHIGAN STATE BOARD OF LAND SURVEYORS, JAN. 28, 1971
REVISED MAY 18, 1975
REVISED JAN., 1983