

**SURVEY & REMONUMENTATION**

APR 25 1995

COMMISSION

OTTAWA COUNTY REMONUMENTATION  
**LAND CORNER RECORDATION CERTIFICATE**  
 Filing Requirement of Act 74, Mich. P.A. 1970

RECORDED

94 DEC -8 PM 12: 35

*Deborah A. Anderson*  
 REGISTER OF DEEDS  
 OTTAWA COUNTY, MI

For corners in

Ottawa  
 (County)

Located In:

Corner Code #

- |                                    |                          |                      |
|------------------------------------|--------------------------|----------------------|
| 1. Public Land Survey              | T <u>8N</u> R <u>13W</u> | <u>C-11 (NW, 32)</u> |
|                                    | T _____ R _____          | <u>Wright Twp.</u>   |
|                                    | T _____ R _____          | _____                |
|                                    | T _____ R _____          | _____                |
| 2. Property Controlling in Section | S _____ T _____ R _____  | _____                |
|                                    | S _____ T _____ R _____  | _____                |
| 3. Miscellaneous Property in Sec.  | S _____ T _____ R _____  | _____                |
|                                    | S _____ T _____ R _____  | _____                |

Register of Deeds Stamp & File Number

4. Lot No. \_\_\_\_\_, Recorded Plat \_\_\_\_\_  
 5. Private Claims \_\_\_\_\_

	A	B	C	D	E	F	G	H	I	J	K	L	M
2	6	5	4	3	2	1							
3													
4	7	8	9	10	11	12							
5													
6	18	17	16	15	14	13							
7													
8	19	20	21	22	23	24							
9													
10	30	29	28	27	26	25							
11													
12	31	32	33	34	35	36							
13													

I, Donald W. Schiele, in a field survey on November 14, 19 94, do hereby certify that under requirements of P.A. 74, Michigan P.A. of 1970, the corner points mentioned in lines 1 and 2 above were in conformance with regulations and rules therefore as required in the current manual of survey instructions of the United States Department of the Interior, Bureau of Land Management or by a decree of a Court of Law and/or that the corner points mentioned in lines 3, 4 and 5 above were in conformance with the rules of the Michigan Board of Land Surveyors or by a Decree of a Court of Law; established, re-established, monumented, re-monumented, recovered, found as expressed below:

**NOTE: Not more than 4 corners, all in the same town and range, may be recorded on this certificate.**

A. Description of original monument and accessories and/or subsequent restoration:  
 C-11 corner common to Sections 29, 30, 31 & 32, Wright Twp.

Original Government Corner Record:	L.C.R.C. recorded in Liber 3, Page 180, 9-16-77
Set corner stake Sec. 29, 30, 31, 32	Found 3/4" Pipe
Stake	N.W. 44.12' T.P.
Sugar 10 N84E 13	S.W. 50.08' P.P.
Do 8 S87W 30	S.E. 76.93' P.P.
Enoch Hammele, Deputy Surveyor	N.W. 65.90' Top of stone Monument.
Between 9-18 and 9-26, 1838	

B. Description of corner evidence found and/or method applied in restoring or reestablishing corner:

C-11 Found 3/4" i.d. X 12" Pipe, 3" below surface in Monument Box, and accepted as a careful and faithful perpetuation of the position of the original corner.

Found nail in NE side of Power Pole	S53°30'E	76.85'
Found PK nail in NE side of Power Pole	S53°30'E	76.78'
Found Nail in SE side of Power Pole	S28°W	50.16'
Found PK nail in SE side of Power Pole	S28°W	50.02'
Top of Stone Monument	N41°30'W	65.6'
Found nail in 21" Ash	N34°30'W	56.44'

P.A. 345 OTTAWA COUNTY  
 PEER APPROVED 11/21/94


C. Description of monument for corner and accessories established to perpetuate locating the position of the corner:

C-11 Replaced 3/4" i.d. X 12" Pipe with 3/4" x 24" Steel Bar & Ottawa County Remon Cap, 2" below surface in Monument Box.

Set Ottawa County Remon Tag & nail in NW side of Wood Post	N30°E	44.86'
Set Ottawa County Remon Tag & nail in NE side of Power Pole	S53°30'E	76.86'
Set Ottawa County Remon Tag & nail in SE side of Power Pole	S28°W	50.02'
Set Ottawa County Remon Tag & nail in South side of 24" Ash	N75°W	134.39'
Set Ottawa County Remon Tag & nail in SW side of 21" Ash	N34°30'W	56.77'
Centerline gravel road to North, 2' West		
Centerline gravel road to South, 1' West		
Centerline asphalt road East & West, 0.5' North		

Signed by Donald W. Schiele  
 Surveyor's Michigan License No. 23517

Date Nov. 18, 1994

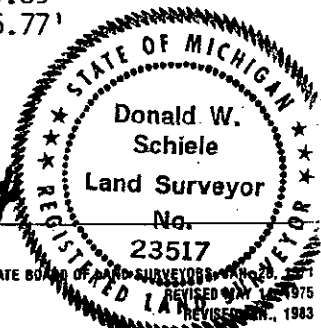

FORM APPROVED BY MICHIGAN STATE BOARD OF LAND SURVEYORS, REVISED MAY 1975