

SURVEY & REMONUMENTATION

APR 25 1995

COMMISSION

OTTAWA COUNTY REMONUMENTATION LAND CORNER RECORDATION CERTIFICATE Filing Requirement of Act 74, Mich. P.A. 1970

RECORDED

94 DEC -8 PM 12:39

Dorothy Carlsson
REGISTER OF DEEDS
OTTAWA COUNTY, MI

For corners in

Ottawa
(County)

Located In:

Corner Code #

- | | | |
|------------------------------------|--------------------------|-------------------------|
| 1. Public Land Survey | T <u>8N</u> R <u>13W</u> | <u>C-12 (W 1/4, 32)</u> |
| | T _____ R _____ | <u>Wright Twp.</u> |
| | T _____ R _____ | _____ |
| | T _____ R _____ | _____ |
| 2. Property Controlling in Section | S _____ T _____ R _____ | _____ |
| | S _____ T _____ R _____ | _____ |
| 3. Miscellaneous Property in Sec. | S _____ T _____ R _____ | _____ |
| | S _____ T _____ R _____ | _____ |

Register of Deeds Stamp & File Number

4. Lot No. _____, Recorded Plat _____
5. Private Claims _____

	A	B	C	D	E	F	G	H	I	J	K	L	M
2	6		5		4		3		2				
3													
4	7		8		9		10		11		12		
5													
6	18		17		16		15		14		13		
7													
8	19		20		21		22		23		24		
9													
10	30		29		28		27		26		25		
11													
12	31		32		33		34		35		36		
13													

I, Donald W. Schiele, in a field survey on October 14, 19 94
do hereby certify that under requirements of P.A. 74, Michigan P.A. of 1970, the corner points mentioned in lines 1 and 2 above were in conformance with regulations and rules therefore as required in the current manual of survey instructions of the United States Department of the Interior, Bureau of Land Management or by a decree of a Court of Law and/or that the corner points mentioned in lines 3, 4 and 5 above were in conformance with the rules of the Michigan Board of Land Surveyors or by a Decree of a Court of Law; established, re-established, monumented, re-monumented, recovered, found as expressed below:

NOTE: Not more than 4 corners, all in the same town and range, may be recorded on this certificate.

A. Description of original monument and accessories and/or subsequent restoration:

C-12 1/4 corner common to Sections 31 & 32, Wright Twp.
Original Government Corner Record: L.C.R.C. recorded in Liber 3, Page 44, 3-29-76
Set qr sec post between Sec. 31 & 32 Set cast iron Mon.
Post 10" Maple E. 73.86'
Elm 15 N79E 15 Fence lines E. & W.
Do 8 S80W 41
Enoch Hammele, Deputy Surveyor
Between 9-18 and 9-26, 1838

B. Description of corner evidence found and/or method applied in restoring or reestablishing corner:

C-12 Found Cast Iron Monument inscribed "Ottawa County Section Corner" 3" below surface, and accepted as a careful and faithful perpetuation of the position of the original corner.
Centerline 15" Hickory S87°30'E 73.7'
On fence line (remnants) to the East
On occupation line to the West

PA. 345 OTTAWA COUNTY

PEER APPROVED 10/17/94

Enoch Hammele


C. Description of monument for corner and accessories established to perpetuate locating the position of the corner:

C-12 Cast Iron Monument inscribed "Ottawa County Section Corner" 3" below surface.
Set Ottawa County Remon Tag & nail in NW side of Power Pole N43°E 184.66' (E)
Set Ottawa County Remon Tag & nail in South side of 15" Hickory S87°30'E 73.59'
Set Ottawa County Remon Tag & nail in West side of 9" Triple Cherry S08°30'E 183.16' (E)
Set Ottawa County Remon Tag & nail in North side of 17" Cherry N90°W 627.99' (E)
On centerline gravel road North & South
On centerline, remnants of old fence line, East
On centerline occupation line, West

Signed by Donald W. Schiele

Date Oct. 17, 1994

Surveyor's Michigan License No. 23517

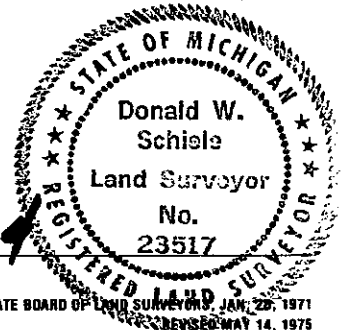

FORM APPROVED BY MICHIGAN STATE BOARD OF LAND SURVEYORS, JAN. 22, 1971
REVISED MAY 14, 1975
REVISED JAN., 1983