

SURVEY & REMONUMENTATION

APR 24 1995

OTTAWA COUNTY REMONUMENTATION LAND CORNER RECORDATION CERTIFICATE Filing Requirement of Act 74, Mich. P.A. 1970

RECORDED

94 DEC 15 AM 11:47

For corners in
Ottawa **COMMISSION**
(County)

Edyee Kellman
REGISTER OF DEEDS
OTTAWA COUNTY, MI

	Located In:	Corner Code #
1. Public Land Survey	T <u>8N</u> R <u>13W</u>	<u>D-3 (N$\frac{1}{4}$, 8)</u> <u>Wright Twp.</u>
	T _____ R _____	_____
	T _____ R _____	_____
	T _____ R _____	_____
2. Property Controlling in Section	S _____ T _____ R _____	_____
	S _____ T _____ R _____	_____
3. Miscellaneous Property in Sec.	S _____ T _____ R _____	_____
	S _____ T _____ R _____	_____

Register of Deeds Stamp & File Number

4. Lot No. _____, Recorded Plat _____
5. Private Claims _____

	A	B	C	D	E	F	G	H	I	J	K	L	M
2	6		5		4		3		2		1		
3			●										
4	7		8		9		10		11		12		
5													
6	18		17		16		15		14		13		
7													
8	19		20		21		22		23		24		
9													
10	30		29		28		27		26		25		
11													
12	31		32		33		34		35		36		
13													

I, Donald W. Schiele, in a field survey on December 7, 19 94, do hereby certify that under requirements of P.A. 74, Michigan P.A. of 1970, the corner points mentioned in lines 1 and 2 above were in conformance with regulations and rules therefore as required in the current manual of survey instructions of the United States Department of the Interior, Bureau of Land Management or by a decree of a Court of Law and/or that the corner points mentioned in lines 3, 4 and 5 above were in conformance with the rules of the Michigan Board of Land Surveyors or by a Decree of a Court of Law; established, re-established, monumented, re-monumented, recovered, found as expressed below:

NOTE: Not more than 4 corners, all in the same town and range, may be recorded on this certificate.

A. Description of original monument and accessories and/or subsequent restoration:

D-3 $\frac{1}{4}$ corner common to Sections 5 & 8, Wright Twp.
Original Government Corner Record: L.C.R.C. recorded in Liber 2, Page 729, 1-14-75
Set qr sec post between Sec. 5 & 8 Fd. Stone, Set Cast Iron Monument
Post SW House Cor. NNE 76.50'
Birch 18 S4E 4 Tel. Pole N 33.18'
Maple 14 N2W 5 10" Maple SW 26.37'
Enoch Hammele, Deputy Surveyor Power Pole ESE 98.36'
Between 9-18 and 9-26, 1838

B. Description of corner evidence found and/or method applied in restoring or reestablishing corner:

D-3 Found Cast Iron Monument (broken), 5" below surface, and accepted as a careful and faithful perpetuation of the position of the original corner.
SW House Corner (foundation) N74°30'E 76.52'
Found nail & Tag # 16042 in NW side of Power Pole S75°30'E 98.68'


P.A. 345 OTTAWA COUNTY

PEER APPROVED 12/12/94

Harold D. Nedewell

C. Description of monument for corner and accessories established to perpetuate locating the position of the corner:

D-3 Broken Cast Iron Monument, 5" below surface.
Set Ottawa County Remon Tag & nail in West side of 10" Elm North 36.22'
SW House Corner (foundation) N22°E 76.52'
Set Ottawa County Remon Tag & nail in SE side of 17" Maple N74°30'E 88.03'
Set Ottawa County Remon Tag & nail in NE side of Power Pole S75°30'E 99.28'
Set Ottawa County Remon Tag & nail in NW side of 12" Ash S76°W 88.18'
On occupation line to North
On fence line to South
Centerline gravel road East & West, 2' North

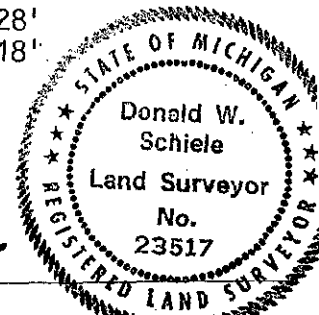

Signed by Donald W. Schiele

Date Dec. 12, 1994

Surveyor's Michigan License No. 23517